


STATE OF KANSAS
STATE CORPORATION COMMISSION

Give All Information Completely
Make Required Affidavit
Mail or Deliver Report to:
Conservation Division
State Corporation Commission
800 Biting Building
Wichita, Kansas

WELL PLUGGING RECORD

Stafford County, Sec. 22 Twp 21S Rge. 12W(E) (W)
Location as "NE/CNW/SW" or footage from lines NE NW NE
Lease Owner Honaker Drilling, Inc.
Lease Name Taylor Well No. 1
Office Address 2008 Lakin - Great Bend, Kansas
Character of Well (completed as Oil, Gas or Dry Hole) _____
Date well completed _____ 19____
Application for plugging filed _____ 19____
Application for plugging approved _____ 19____
Plugging commenced February 23 1955
Plugging completed February 28 1955
Reason for abandonment of well or producing formation _____

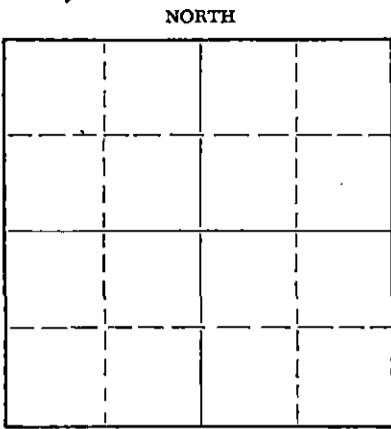

Locate well correctly on above
Section Plat

If a producing well is abandoned, date of last production _____ 19____
Was permission obtained from the Conservation Division or its agents before plugging was commenced? Yes

Name of Conservation Agent who supervised plugging of this well Merle Rives
Producing formation _____ Depth to top _____ Bottom _____ Total Depth of Well 3616' Feet
Show depth and thickness of all water, oil and gas formations.

OIL, GAS OR WATER RECORDS

CASING RECORD

FORMATION	CONTENT	FROM	TO	SIZE	PUT IN	PULLED OUT
				8-5/8"	235'	None
				5-1/2"	3615'	2605'

Describe in detail the manner in which the well was plugged, indicating where the mud fluid was placed and the method or methods used in introducing it into the hole. If cement or other plugs were used, state the character of same and depth placed, from _____ feet to _____ feet for each plug set.

Cement inside casing was drilled out to 3606'
and casing was perforated from 3266' to 3269'.
Filled hole with sand from 3606' to 3255' and
ran 5 sacks of cement. Mudded the hole to 230',
set a 10' rock bridge and ran 22 sacks of cement.
Mudded the hole to 35', set a 10' rock bridge
and ran 10 sacks of cement on top. Plugging
completed.

RECEIVED
STATE CORPORATION COMMISSION

MAR 10 1955

CONSERVATION DIVISION
Wichita, Kansas

3-10-55

(If additional description is necessary, use BACK of this sheet)

Name of Plugging Contractor West Supply Co., Inc.
Address Chase, Kansas

STATE OF Kansas, COUNTY OF Barton, ss.
E. O. Squires (employee of owner) or (owner or operator) of the above-described well, being first duly sworn on oath, says: That I have knowledge of the facts, statements, and matters herein contained and the log of the above-described well as filed and that the same are true and correct. So help me God.

(Signature) E. O. Squires

(Address)

SUBSCRIBED AND SWORN TO before me this 8th day of March 1955

Kenneth D. Fischer
Notary Public.

My commission expires 6-25-55

PLUGGING
FILE SEC 22 T 21 R 12W
BOOK PAGE 96 LINE 3

HONAKER DRILLING COMPANY
2008 LAKIN
GREAT BEND, KANSAS

Taylor #1
Sec: 22-21S-12W
Loc: NE NW NE
Stafford County, Kansas

Total Depth: 3616 ft.
Comm: 8-7-53
Comp: 8-18-53
Elevation: 1840 D.F.
Casing: 8-5/8" 235'
5-1/2" 3616'

Operator: Honaker Drilling Co., et al
Contractor: Honaker Drilling Co.

0	220	Clay & Sand	
220	235	Shale	8-5/8" casing cemented at 235' with 150 sacks cement.
235	625	Red Bed	
625	1255	Shale & Shells	
1255	1340	Salt & Shale	
1340	1635	Shale & Shells	
1635	3025	Lime & Shale	
3025	3517	Lime	
3517	3567	Lime & Shale	
3567	3616	Lime	
3616	Total Rotary Depth		5-1/2" casing cemented at 3616' with 175 sacks cement.

I certify that this is the true and correct copy of the above log,
to the best of my knowledge.

J. J. Honaker

Subscribed and sworn to before me this 21 day of August, 1953.

Edith D. Parker
Notary Public

My Commission Expires: 6-25-55

PLUGGING
WELL SEC 22 21 N 12W
BLOCK PAGE 96 LINE 3