


WELL PLUGGING RECORD

Give All Information Completely  
Make Required Affidavit  
Mail or Deliver Report to:  
Conservation Division  
State Corporation Commission  
800 Bittling Building  
Wichita, Kansas

NORTH

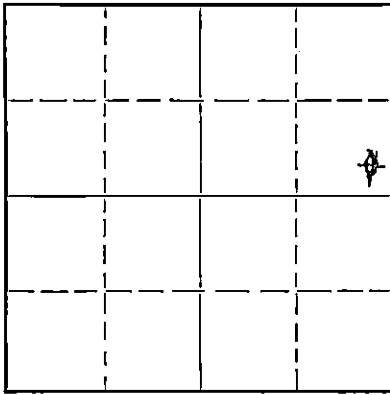

Locate well correctly on above  
Section Plat

Stafford County. Sec. 22 Twp. 21 Rge. 12 (E) (W)  
Location as "NE/CNW $\frac{1}{4}$ /SW $\frac{1}{4}$ " or footage from lines SE SE NE  
Lease Owner Virginia Drilling Co., Inc. et al  
Lease Name Taylor Well No. 2  
Office Address 701 Brown Bldg., Wichita 2, Kansas  
Character of Well (completed as Oil, Gas or Dry Hole) Oil well 1947  
Date well completed March 28, 1947  
Application for plugging filed April 7 19 51  
Application for plugging approved April 7 19 51  
Plugging commenced April 7 19 51  
Plugging completed April 7 19 51  
Reason for abandonment of well or producing formation Oil depleted out

If a producing well is abandoned, date of last production August 23 19 50  
Was permission obtained from the Conservation Division or its agents before plugging was commenced? yes

Name of Conservation Agent who supervised plugging of this well C. D. Stough, Box 207, Great Bend, Kansas  
Producing formation Arbuckle Depth to top 3570 Bottom 3591 Total Depth of Well 3591 Feet  
Show depth and thickness of all water, oil and gas formations.

OIL, GAS OR WATER RECORDS

CASING RECORD

Formation	Content	From	To	Size	Put In	Pulled Out
				8-5/8"	285	none
				5 1/2"	3572	2346'

Describe in detail the manner in which the well was plugged, indicating where the mud fluid was placed and the method or methods used in introducing it into the hole. If cement or other plugs were used, state the character of same and depth placed, from feet to feet for each plug set.

3240 - 3210 Sand  
3210 - 3165 5 sks. cement  
3165 - 285 Mudded  
285 - 270 Rock bridge  
270 - 230 15 sks. cement  
230 - 30 Mud  
30 ft. to cellar - 10 sks. cement

RECEIVED  
STATE CORPORATION COMMISSION  
MAY 5 - 1951 5-5-51  
CONSERVATION DIVISION  
Wichita, Kansas

(If additional description is necessary, use BACK of this sheet)

Correspondence regarding this well should be addressed to Virginia Drilling Co., Inc.  
Address 701 Brown Bldg., Wichita 2, Kansas

STATE OF Kansas, COUNTY OF Sedgwick, ss.  
S. A. Murphy (employee of owner) or (owner or operator) of the above-described well,  
being first duly sworn on oath, says: That I have knowledge of the facts, statements, and matters herein contained and the log of the above-described well as filed and that the same are true and correct. So help me God.

(Signature) *S. A. Murphy*  
701 Brown Bldg., Wichita 2, Kansas  
(Address)

SUBSCRIBED AND SWORN to before me this 3<sup>rd</sup> day of May, 19 51

*Inez M. Newman*  
Notary Public.

My commission expires March 15, 1954

PLUGGING  
FILE SEC 22 T 21 R 12 W  
BOOK PAGE 27 LINE 27

Name: Taylor #2  
 Location: SE/4 SE/4 NE/4 Section 22-218-12W, Stafford County, Kansas  
 Company: Virginia Drilling Company, Inc. & E. H. Adair  
 Contractor: Virginia Drilling Company, Inc.  
 Commenced: January 23, 1947  
 Completed: March 28, 1947  
 Total Depth: 3591  
 Elevation: 1847

<u>FORMATION</u>	<u>DEPTH</u>	<u>TOPS</u>
Sand	0-210	Anhydrite 630
Shale	210-285	Lansing-Kansas City 3244
Shale	285-630	Sooy Conglomerate 3495
Anhydrite	630-660	Simpson 3529
Shale & Shells	660-1175	Arbuckle 3570
Salt & Shells	1175-1220	
Salt & Shale	1220-1420	
Lime-Broken	1420-1530	
Lime-Rough	1530-1595	Set 8 5/8" csg. @ 285
Lime	1595-1680	Set 5 1/2" csg. @ 3572
Lime-cherty	1680-1770	
Lime	1770-1805	
Lime, sandy	1805-1830	Circulate @ 3572 - 1 3/4 hrs.
Hard Lime	1830-1835	" 3574 - 2 hrs.
Lime & Shale	1835-1935	
Lime-cherty streaks	1935-2005	
Lime & Shale	2005-2065	
Shale	2065-2165	
Shale & Shells	2165-2280	
Shale & Lime	2280-2380	
Shale & Shells	2380-2580	
Lime	2580-2665	
Lime & Shale	2665-2740	
Lime	2740-2800	
Sand	2800-2822	
Lime	2822-3115	
Lime & Shale	3115-3235	
Shale	3235-3244	
Lime	3244-3275	
Lime & Shale	3275-3315	
Lime	3315-3445	
Lime & Shale	3445-3505	
Shale	3505-3565	
Simpson	3565-3572	
Arbuckle	3572-3574-3591	

Now comes S. A. Murphy, who states that he is familiar with the drilling of oil and gas wells and known of his own knowledge the Taylor #2 located in the SE/4 SE/4 NE/4 Section 22-218-12W, Stafford County, Kansas, was drilled to a total depth of 3591 feet, Oil being found in the siliceous lime.

*S. A. Murphy*

Subscribed and sworn to before me, a Notary Public, this 18<sup>th</sup> day of March, 1947.

*Wesley B. ...*

My Commission expires: February 5, 1949.

PLUGGING  
 FILE SEC 22-218-12W  
 BOOK PAGE 27 LINE 27