


STATE OF KANSAS
-STATE CORPORATION COMMISSION

WELL PLUGGING RECORD

Give All Information Completely
Make Required Affidavit
Mail or Deliver Report to:
Conservation Division
State Corporation Commission
800 Bitting Building
Wichita, Kansas

NORTH

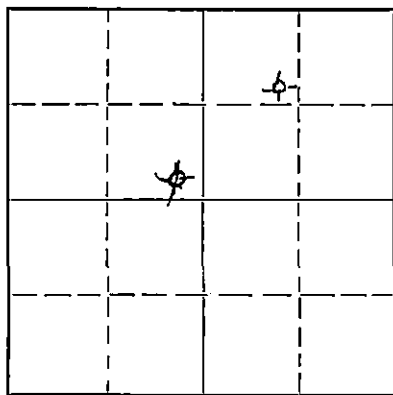

Locate well correctly on above
Section Plat

Stafford County. Sec. 22 Twp. 21 Rge. 12 (E) (W)
Location as "NE/CNW $\frac{1}{4}$ SW $\frac{1}{4}$ " or footage from lines SE NW NE
Lease Owner Virginia Drilling Co., Inc. & Franco Central Oil Co.
Lease Name Taylor Well No. 4
Office Address 701 Brown Bldg., Wichita 2, Kansas
Character of Well (completed as Oil, Gas or Dry Hole) Dry Hole
Date well completed December 20, 1950 19
Application for plugging filed January 9 19 51
Application for plugging approved January 9 19 51
Plugging commenced January 9 19 51
Plugging completed January 9 19 51
Reason for abandonment of well or producing formation dry hole

If a producing well is abandoned, date of last production 19
Was permission obtained from the Conservation Division or its agents before plugging was commenced? yes

Name of Conservation Agent who supervised plugging of this well C. D. Stough, Box 207, Great Bend, Kansas
Producing formation Depth to top Bottom Total Depth of Well 3581 Feet
Show depth and thickness of all water, oil and gas formations.

OIL, GAS OR WATER RECORDS

CASING RECORD

Formation	Content	From	To	Size	Put In	Pulled Out
				8-5/8"	348	none
				5 1/2"	3566	2715

Describe in detail the manner in which the well was plugged, indicating where the mud fluid was placed and the method or methods used in introducing it into the hole. If cement or other plugs were used, state the character of same and depth placed, from feet to feet for each plug set.

3281 to 3270 ft. - Filled with sand

3270 to 3240 ft. - 5 sacks cement

3240 to 287 - Mudded

287 to 270 - Rock bridge

270 - 230 - 15 sacks cement

230 - 20 - Mud

20ft. to cellar - 10 sacks cement

RECEIVED
STATE CORPORATION COMMISSION
JAN 23 1951
CONSERVATION DIVISION
Wichita, Kansas
1-23-51

(If additional description is necessary, use BACK of this sheet)

Correspondence regarding this well should be addressed to Virginia Drilling Co., Inc.
Address 701 Brown Bldg., Wichita 2, Kansas

STATE OF Kansas, COUNTY OF Sedgwick, ss.
S. A. Murphy (employee of owner) or (owner or operator) of the above-described well,
being first duly sworn on oath, says: That I have knowledge of the facts, statements, and matters herein contained and the log of the above-described well as filed and that the same are true and correct. So help me God.

(Signature) *S. A. Murphy*
701 Brown Bldg., Wichita 2, Kansas
(Address)

SUBSCRIBED AND SWORN to before me this 22nd day of January, 1951

Jerry M. Newman
Notary Public.

My commission expires March 15, 1954

PLUGGING
FILE SEC 22 T 21 R 12W
BOOK PAGE 55 LINE 20

Well: Taylor No. 4
 Location: SE NW NE Section 22-21-12, Stafford County, Kansas
 Company: Virginia Drilling Co., Inc. & Franco Central Oil Co.
 Contractor: Virginia Drilling Co., Inc.
 Commenced: November 9, 1950
 Completed: December 20, 1950
 Total Depth: 3581
 Elevation: 1841 DF

FORMATION	DEPTH		
Clay-shell	0-200		
Red Bed	200-283	Set 8-5/8" csg. @ 348'	
Red Bed-shale	283-495	5 1/2" csg. @ 3566'	
Red Bed	495-700		
Anhydrite	700-725		
Shells-shale	725-1135		
Salt	1135-1300		
Shale-shells	1300-1490	TOPS:	
Shale-lime	1490-1990		
Shale	1990-2075	Heebner Shale	3093
Shale-lime	2075-2100	Lansing	3234
Lime	2100-2275	Conglomerate	3470
Shale	2275-2370	Viola Chert	3491
Shale-lime	2370-2720	Simpson	3511
Lime	2720-2860	Arbuckle	3564
Lime-shale	2860-2983		
Lime	2983-3030		
Hard Lime	3030-3064		
Lime	3064-3471		
Conglomerate	3471-3520		
Conglomerate-shale	3520-3556		
Shale	3556-3564		
Arbuckle Lime	3564-3581		

Now comes S. A. Murphy, who states that he is familiar with the drilling of oil and gas wells and knows of his own knowledge that the Taylor # 4 located in the SE NW NE Sec. 22-21-12, Stafford County, Kansas, was drilled to a total depth of 3581 feet. Same was plugged and abandoned.

Subscribed and sworn to before me this 22nd day of January, 1951.

My commission expires March 15, 1954.

PLUGGING
 FILE SEC 27 T 21 R 12 W
 BOOK PAGE 55 LINE 20

RECEIVED
 STATE CORPORATION COMMISSION
 JAN 23 1951
 CONSERVATION DIVISION
 Wichita, Kansas