


WELL PLUGGING RECORD

Give All Information Completely
Make Required Affidavit
Mail or Deliver Report to:
Conservation Division
State Corporation Commission
212 North Market, Insurance Bldg.
Wichita, Kansas

NORTH

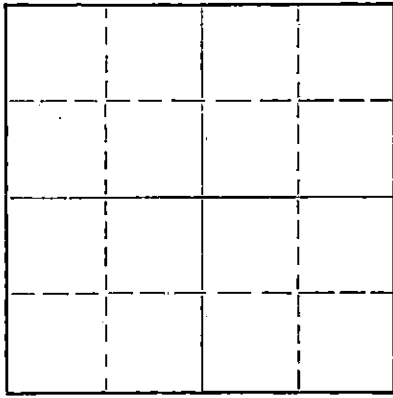

Locate well correctly on above
Section Plat

Stafford County, Sec. 11 Twp. 21S Rge. 13W (E) (W)
Location as "NE/CNW/SW" or footage from lines SEXXWXXX NW SW NE
Lease Owner ALPINE OIL & ROYALTY CO., INC.
Lease Name Bennett (Nixon) Well No. 1
Office Address 800 Bitting Building, Wichita, Ks.
Character of Well (completed as Oil, Gas or Dry Hole) oil well
Date well completed May 20, 1953 19
Application for plugging filed March 1, 1963 19
Application for plugging approved March 4, 1963 19
Plugging commenced March 6, 1963 19
Plugging completed March 10, 1963 19
Reason for abandonment of well or producing formation non productive in
commercial quantities
If a producing well is abandoned, date of last production November 4 19 62
Was permission obtained from the Conservation Division or its agents before plugging was com-
menced? yes

Name of Conservation Agent who supervised plugging of this well W. L. Nichols
Producing formation Lansing-KC Depth to top 3276 Bottom Total Depth of Well 3558 Feet
Show depth and thickness of all water, oil and gas formations.

OIL, GAS OR WATER RECORDS

CASING RECORD

FORMATION	CONTENT	FROM	TO	SIZE	PUT IN	PULLED OUT
				8 5/8	283'	Cemented
				5 1/2	3555'	2817

Describe in detail the manner in which the well was plugged, indicating where the mud fluid was placed and the method or methods used in introducing it into the hole. If cement or other plugs were used, state the character of same and depth placed, from feet to feet for each plug set.

Set plug at 3260 feet and ran 4 sacks of cement from 3260 feet to 3240 feet, mudded from 3240 to 200 feet, rock bridge 200 ft. to 190 ft., ran 20 sacks of cement from 190 ft. to 130 ft., mudded from 130 ft. to 35 ft. and ran 10 sacks of cement from 35 feet to base of cellar

RECEIVED
STATE CORPORATION COMMISSION

MAR 26 1963

3-26-63
CONSERVATION DIVISION
Wichita, Kansas

(If additional description is necessary, use BACK of this sheet)

Name of Plugging Contractor Glenn and Smith Pipe Pulling Company
Address Ellinwood, Ks.

STATE OF Kansas, COUNTY OF Sedgwick, ss.
Thomas M. McCaul (employee of owner) or (owner or operator) of the above-described

well, being first duly sworn on oath, says: That I have knowledge of the facts, statements, and matters herein contained and the log of the above-described well as filed and that the same are true and correct. So help me God.

(Signature) Thomas M. McCaul

800 Bitting Building, Wichita, Ks.
(Address)

SUBSCRIBED AND SWORN to before me this 15th day of March, 19 63

August 10, 1965

My commission expires

Virginia Mundell
Notary Public.

WELL LOG BUREAU—KANSAS GEOLOGICAL SOCIETY
503 East Murdock, Wichita, Kansas

Company- LEE PHILLIPS OIL CO.
Farm- Nixon No. 1

SEC. 11 T. 21 R. 13W
NW SW NE

Total Depth. 3558

Comm. 5-9-53


Shot or Treated.

Contractor.

Issued. 7-18-53

Comp. 5-20-53

County Stafford
KANSAS

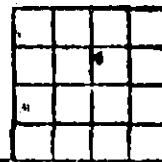

Elevation. 1870' DP

Production Pot. 376 bbls.

CASING:

8 5/8 set at 283' w/ 250 sx cement
5 1/2 set at 3555' w/ 125 sx cement

Figures indicate bottom of formations.

sand & clay	130
shale	195
shale & shells	240
red rock	635
red bed	708
anhydrite	736
shale & shells	1300
salt	1430
shale & shells	1495
sand & shale	1585
lime & shale	2260
shale & shells	2720
lime & shale	2950
lime	3000
lime & shale	3300
lime	3520
conglomerate	3558
Total Depth	

TOPS:

Heebner	3125
Brown lime	3258
Kansas City	3276
Conglomerate	3515
Arbuckle	3558

DST #1: 3334-44', open 1 hr. rec. 65'
watery OCM, SG, BHP 375#

DST #2: 3394-3401, gas to surf. in
55 min. open 1 hr. rec. 150' MC oil
BHP 1190# FP 170#

DST #3: 3431-39, weak blow 28 min.
open 1 hr. rec 20' mud, BHP 1140#

Perf. 4# holes 3391-99, 2000 gal
acid after load swdb approx 35 to
40 BOPH, no water/

We hereby certify the foregoing to be a true and correct copy of the driller's log of the well drilled in the NW SW NE of Section 11, Township 21 South, Range 13 West, Stafford County, Kansas.

ALPINE OIL & ROYALTY CO., INC.

By: Thomas M. M. Carl

SUBSCRIBED AND SWORN TO before me this 15th day of March, 1963.

Virginia Mundell
Virginia Mundell, Notary Public

MY COMMISSION EXPIRES:
August 10, 1965