

Give All Information Completely
Make Required Affidavit
Mail or Deliver Report to:
Conservation Division
State Corporation Commission
800 Bittling Building
Wichita, Kansas

WELL PLUGGING RECORD

County, Stafford County, Sec. 11 Twp. 21S Rge. 13W (E).....(W)

Location as "NE/CNW $\frac{1}{4}$ SW $\frac{1}{4}$ " or footage from lines NE NW SE

Lease Owner Clifton L. McCown

Lease Name Allphin Well No. 1

Office Address 531 Petroleum Bldg.

Character of Well (completed as Oil, Gas or Dry Hole) Dry Hole

Date well completed 8-1 1953

Application for plugging filed 8-1 1953

Application for plugging approved 8-1 1953

Plugging commenced 8-1 1953

Plugging completed 8-1 1953

Reason for abandonment of well or producing formation Dry Hole

If a producing well is abandoned, date of last production 19

Was permission obtained from the Conservation Division or its agents before plugging was commenced? Yes

Name of Conservation Agent who supervised plugging of this well M.A. Rines

Producing formation..... Depth to top..... Bottom..... Total Depth of Well 3564 Feet

Show depth and thickness of all water, oil and gas formations.

OIL, GAS OR WATER RECORDS

CASING RECORD

Formation	Content	From	To	Size	Put In	Pulled Out
				8 5/8	288'	None

Describe in detail the manner in which the well was plugged, indicating where the mud fluid was placed and the method or methods used in introducing it into the hole. If cement or other plugs were used, state the character of same and depth placed, from.....feet to.....feet for each plug set.

3564' to 240' Hole filled w/ heavy mud
240' to 238' Howco Plug
238' - 20 Sks. Cement on top of Howco Plug, Top of Cement to 40'
Hole filled w/ Heavy mud 40' to surface - 10 Sks. Cement

8-8-1953

(If additional description is necessary, use BACK of this sheet)

Name of Plugging Contractor Bud Edwards Drilling Company

Address 510 Petroleum Building, Wichita, Kansas

STATE OF Kansas COUNTY OF Sedgwick, ss.

.....(employee of owner) or (owner or operator) of the above-described well, being first duly sworn on oath, says: That I have knowledge of the facts, statements, and matters herein contained and the log of the above-described well as filed and that the same are true and correct. So help me God.


(Signature) Bud Edwards

510 Petroleum Building
(Address)

SUBSCRIBED AND SWORN to before me this 6th day of August, 1953.

My commission expires March 14, 1956

Rouise Burnett
Notary Public.

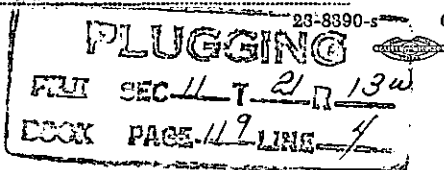

Bud Edwards  *Drilling Co.*

DRILLING CO.

August 1, 1953


Mr. Clifton L. McCown
531 Petroleum Bldg.
Wichita, Kansas

Commenced 7-18-53
Completed & Plugged 8-1-53
Surface 288' 8 5/8"

Well Drillers Log for Allphin #1 well, located NE NW SE,
Section 11-21S-13W., Stafford County, Kansas

0'	65'	Sand	
65'	95'	Shale w/ Shells	
95'	155'	Sand	
155'	312'	Shale w/ Red Rock	
312'	725'	Red Rock	
725'	775'	Anhydrite	
775'	1040'	Shale w/ Shells	
1040'	1500'	Shale w/ Lime Streaks	
1500'	1885'	Lime	
1885'	2225'	Lime w/ Shale Streaks	
2225'	2855'	Shale w/ Lime Streaks	
2855'	3215'	Lime	
3215'	3262'	Shale	
3262'	3540'	Lime	
3540'	3549'	Conglomerate	
3549'	3564'	Arbuckle Lime	T.D.

Bud Edwards Drilling Co.

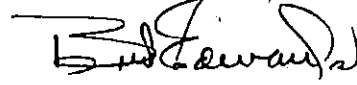

Bud Edwards

PLUGGING
FILE SEC 11 T 21 R 130
BOOK PAGE 119 LINE 4

RECEIVED
STATE CORPORATION COMMISSION
AUG - 8 1953
CONSERVATION DIVISION
Wichita, Kansas
8-8-53