

WELL PLUGGING RECORD

Give All Information Completely
Make Required Affidavit
Mail or Deliver Report to:
Conservation Division
State Corporation Commission
800 Pitting Building
Wichita, Kansas

Stafford

County, Sec. 11 Twp. 21 Rge. (E) 13 (W)

Location as "NE/CNW $\frac{1}{4}$ SW $\frac{1}{4}$ " or footage from lines SE NE NW

Lease Owner Lee Phillips Oil Company

Lease Name Sipes "B" Well No. 1

Office Address 1107 Union National Bank Building, Wichita 2, Kansas

Character of Well (completed as Oil, Gas or Dry Hole) Dry Hole

Date well completed 6-29-53 19

Application for plugging filed 6-29-53 19

Application for plugging approved 6-29-53 19


Plugging commenced 6-29-53 19

Plugging completed 6-29-53 19

Reason for abandonment of well or producing formation Dry Hole

If a producing well is abandoned, date of last production _____ 19

Was permission obtained from the Conservation Division or its agents before plugging was commenced? yes

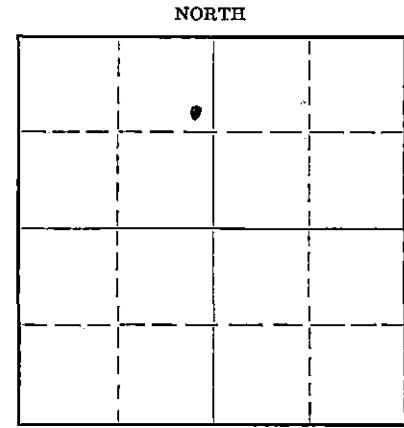

Locate well correctly on above Section Plat

Name of Conservation Agent who supervised plugging of this well C. D. Stough

Producing formation _____ Depth to top _____ Bottom _____ Total Depth of Well 353 1/2 Feet

Show depth and thickness of all water, oil and gas formations.

OIL, GAS OR WATER RECORDS

CASING RECORD

Formation	Content	From	To	Size	Put In	Pulled Out
	Surface Pipe	0	557'	8-5/8"	557'	None

Describe in detail the manner in which the well was plugged, indicating where the mud fluid was placed and the method or methods used in introducing it into the hole. If cement or other plugs were used, state the character of same and depth placed, from _____ feet to _____ feet for each plug set.

Filled hole with heavy mud from total depth to 240'. Bridged hole at 240'. Run 20 sacks cement. Plug 240' up. Bridged at 40'. Dumped 10 sacks cement 20' to base of cellar.

7-3-1953

(If additional description is necessary, use BACK of this sheet)

Name of Plugging Contractor Isarn Drilling Company
Address P. O. Box 45, Ellinwood, Kansas

STATE OF KANSAS, COUNTY OF BARTON, ss.
M. M. Shropshire (employee of owner) Isarn Drilling Company of the above-described well,

being first duly sworn on oath, says: That I have knowledge of the facts, statements, and matters herein contained and the log of the above-described well as filed and that the same are true and correct. So help me God.

(Signature) M. M. Shropshire


Lyons, Kansas

(Address)

SUBSCRIBED AND SWORN to before me this 30th day of June, 1953

George A. Meyer
Notary Public.

My commission expires Feb. 10, 1955.

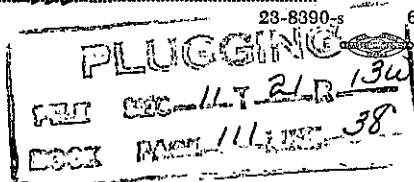

WELL LOG

LEE PHILLIPS OIL COMPANY, Owner - Sipes "B" #1
 SE/4 NE/4 NW/4 Section 11, Township 21, Range 13W,
 Stafford County, Kansas

Elevation: 1870 DF (Est)

Figures indicate bottom of formation

Pipe Record:

8-5/8" set at 557'

Rotary Commenced 6-21-53
 Completed 6-29-53

0	to	130	sand
		295	shale & shells
		415	red bed
		535	sand & shale
		557	red rock
		713	red bed
		744	Anhydrite
		1205	shale & shells
		1400	salt
		1535	shale & shells
		2300	lime & shale
		2630	shale & shells
		3127	lime & shale
		3132	Heebner
		3534	lime & shale
		3534	Total Rotary Depth

STATE OF KANSAS)
 COUNTY OF BARTON) SS

I, M. M. Shropshire, Drilling Superintendent of the above-described well, being first duly sworn on oath, declare: That I have knowledge of the facts, statements and matters herein contained pertaining to the log of the above-described well, as filed, and that the same are true and correct.

M. M. Shropshire

Subscribed and Sworn to before me this 30th day of June, 1953.

George A Meyer
 Notary Public

My commission expires Feb. 10, 1955.

PLUGGING
 FILE SEC 11 T 21 R 13W
 BOOK PAGE 111 LINE 38

RECEIVED
 STATE CORPORATION COMMISSION
 JUL 3 X 1953
 CONSERVATION DIVISION
 Wichita, Kansas