


WELL PLUGGING RECORD

Give All Information Completely
Make Required Affidavit
Mail or Deliver Report to:
Conservation Division
State Corporation Commission
211 No. Broadway
Wichita, Kansas

NORTH

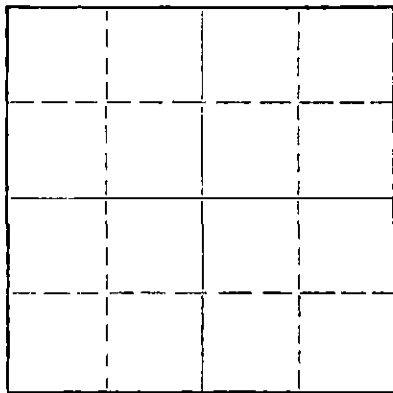

Locate well correctly on above
Section Plat

Stafford County, Sec. 11 Twp. 21 Rge. 13 (E) W (W)
Location as "NE/CNW/SW" or footage from lines NE NW NW
Lease Owner Circle Oil Company
Lease Name Sipes Well No. 1
Office Address Wichita, Kansas
Character of Well (completed as Oil, Gas or Dry Hole)
Date well completed 19____
Application for plugging filed 19____
Application for plugging approved 19____
Plugging commenced 11-23-64 19____
Plugging completed 11-27-64 19____
Reason for abandonment of well or producing formation Depleted.
If a producing well is abandoned, date of last production 19____
Was permission obtained from the Conservation Division or its agents before plugging was commenced? yes

Name of Conservation Agent who supervised plugging of this well Archie Elving
Producing formation _____ Depth to top _____ Bottom _____ Total Depth of Well 3584 Feet
Show depth and thickness of all water, oil and gas formations.

OIL, GAS OR WATER RECORDS

CASING RECORD

FORMATION	CONTENT	FROM	TO	SIZE	PUT IN	PULLED OUT
				8-5/8"	283'	None
				5-1/2"	3599'	3000'

Describe in detail the manner in which the well was plugged, indicating where the mud fluid was placed and the method or methods used in introducing it into the hole. If cement or other plugs were used, state the character of same and depth placed, from _____ feet to _____ feet for each plug set.

Checked hole to 3584', sanded hole to 3500' and dumped 5 sacks of cement @ 3500' with dump bailer. Pulled 5 1/2" casing, set plug @ 275', rock bridge to 265' and dumped 4 sacks of cement with calcium chloride. Let set 2 hrs. Could not bail hole down. Dumped 4 sacks of cement with bailer and let set over night. Bailed hole to 255' and dumped 17 sacks of cement @ 255'. Mudded hole to 35', set rock bridge to 30' and ran 10 sacks of cement to base of cellar.

RECEIVED
STATE CORPORATION COMMISSION
DEC 4 1964
12-4-64
CONSERVATION DIVISION
Wichita, Kansas

PLUGGING COMPLETE.

(If additional description is necessary, use BACK of this sheet)

Name of Plugging Contractor KNIGHT CASING PULLING COMPANY
Address CHASE, KANSAS

STATE OF KANSAS, COUNTY OF RICE, ss.
Noel J. Knight (employee of owner) or (owner) of the above-described well, being first duly sworn on oath, says: That I have knowledge of the facts, statements, and matters herein contained and the log of the above-described well as filed and that the same are true and correct. So help me God.

(Signature) Noel J. Knight
Chase, Kansas
(Address)

SUBSCRIBED AND SWORN TO before me this 1st day of December, 1964.

My commission expires May 20, 1968
Milton J. Volin
Notary Public.

DRILLERS LOG

No. 1 Sipes

CASING RECORD: COMPANY: Circle Oil Company DESCRIPTION:
 8 5/8" @ 283' CONTRACTOR: Red Tiger Drilling Co. NE NW NW
 w/225 sx cement COMMENCED: October 30, 1964 11-219-13W
 5 1/2" @ 3599' COMPLETED: November 7, 1964 Stafford Co., Kans.
 w/125 sx cement ELEVATION:
 TOTAL DEPTH: 3600'

<u>FORMATION</u>	<u>FROM</u>	<u>TO</u>	<u>REMARKS</u>
Clay Sand & Surface	0	160	
Clay & Shale	160	285	
Redbed & Shale	285	703	
Anhydrite	703	728	
Shale & Shells	728	1545	
Shale & Lime	1545	3085	
Lime	3085	3600	

RECEIVED
STATE CORPORATION COMMISSION

NOV 24 1964

CONSERVATION DIVISION
Wichita, Kansas

I certify that this is a true and correct copy of the above log to the best of my knowledge.

RED TIGER DRILLING COMPANY

Maxine V. Head
Maxine V. Head

Subscribed and sworn to before me this 9th day of November, 1964.

Jean Holler
Notary Public

My Commission Expires:

5-22-66