

WELL PLUGGING RECORD

Give All Information Completely
Make Required Affidavit
Mail or Deliver Report to:
Conservation Division
State Corporation Commission
806 Loring Building
Wichita, Kansas

Stafford County, Sec. 11 Twp. 21 Rge. (E) 13(W)

Location as "NE/CNW/SW" or footage from lines SW SE NW

Lease Owner Lee Phillips Oil Company

Lease Name Sipes Well No. 2

Office Address 1407 Union Nat'l Bank Bldg, Wichita, Kansas

Character of Well (completed as Oil, Gas or Dry Hole) Dry Hole

Date well completed February 26, 1954 19

Application for plugging filed February 26, 1954 19

Application for plugging approved February 26, 1954 19


Plugging commenced February 26, 1954 19

Plugging completed February 26, 1954 19

Reason for abandonment of well or producing formation Dry Hole

If a producing well is abandoned, date of last production 19

Was permission obtained from the Conservation Division or its agents before plugging was commenced? Yes

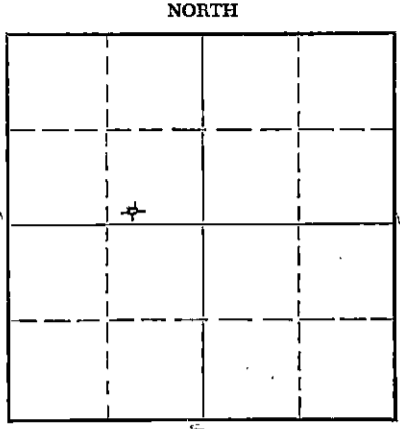

Locate well correctly on above Section Plat

Name of Conservation Agent who supervised plugging of this well M. A. Rives

Producing formation Depth to top Bottom Total Depth of Well 3550 Feet

Show depth and thickness of all water, oil and gas formations.

OIL, GAS OR WATER RECORDS

CASING RECORD

FORMATION	CONTENT	FROM	TO	SIZE	PUT IN	PULLED OUT
	Surface Pipe	0	508'	8-5/8"	508'	None

Describe in detail the manner in which the well was plugged, indicating where the mud fluid was placed and the method or methods used in introducing it into the hole. If cement or other plugs were used, state the character of same and depth placed, from feet to feet for each plug set.

Filled hole with heavy mud to 240'.
Bridged hole at 240'. Ran 20 sacks
cement 240' up. Bridge hole at 35',
ran 10 sacks cement, plug 35' to base
of cellar.

(If additional description is necessary, use BACK of this sheet)

Name of Plugging Contractor Isern Drilling Company
Address Box 45, Ellinwood, Kansas.

STATE OF KANSAS, COUNTY OF BARTON, ss.
M. M. Shropshire (employee of owner) or (owner or operator)

well, being first duly sworn on oath, says: That I have knowledge of the facts, statements, and matters herein contained and the log of the above-described well as filed and that the same are true and correct. So help me God.

(Signature) M. M. Shropshire
Lyons, Kansas (Address)

SUBSCRIBED AND SWORN TO before me this 26th day of February, 1954

George A. Meyer
Notary Public.

My commission expires Feb. 10, 1955.

PLUGGING
FILE SEC 11 T 21 R 13W
BOOK PAGE 16 LINE 30

3-1-1954

WELL LOG

Lee Phillips Oil Company, Owner - Sipes #2
 SW/4 SE/4 NW/4 Section 11, Township 21, Range 13W,
 Stafford County, Kansas

Elevation: 1870 DF

Figures indicate bottom of formation
 0 to 20 clay

Pipe Record:

8-5/8" set at 508'

TOPS: RBM

Heebner 3135
 Brown Lime 3261
 Lansing 3280
 Conglomerate 3521

135 sand
 155 shale
 218 shale & shells
 260 sand
 305 Red bed
 410 sand
 710 Red rock
 735 Anhydrite
 1200 shale & shells
 1500 salt
 1560 shale & shells
 2210 Lime & shale
 2600 shale & shells
 3380 lime & shale
 3550 Lime
 3550 Total Depth

Rotary Commenced 2-18-54
 Completed 2-26-54

STATE OF KANSAS)
 COUNTY OF BARTON) SS

I, M. M. Shropshire, Drilling Superintendent of the above-described well, being first duly sworn on oath, declare: That I have knowledge of the facts, statements and matters herein contained pertaining to the log of the above-described well, as filed, and that the same are true and correct.

M. M. Shropshire

Subscribed and Sworn to before me this 26th day of February, 1954.

George A Meyer
 Notary Public

My commission expires Feb. 10, 1955.

