


STATE OF KANSAS
STATE CORPORATION COMMISSION

Give All Information Completely
Make Required Affidavit
Mail or Deliver Report to:
Conservation Division
State Corporation Commission
880 Bitting Building
Wichita, Kansas

WELL PLUGGING RECORD

NORTH

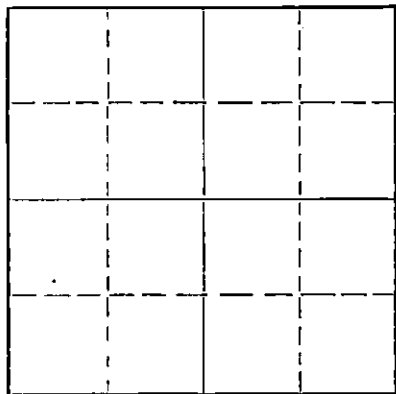

Locate well correctly on above
Section Plat

Ellis County, Sec. 33 Twp. 13S Rge. (E) 17(W)
Location as "NE/CNW/SWK" or footage from lines NW NE NE
Lease Owner ALPINE OIL & ROYALTY CO., INC.
Lease Name Braun Well No. 1
Office Address 1100 Bitting Bldg. Wichita, Kansas
Character of Well (completed as Oil, Gas or Dry Hole) Dry Hole
Date well completed July 25, 1952 19
Application for plugging filed July 25, 1952 19
Application for plugging approved July 25, 1952 19
Plugging commenced July 25, 1952 19
Plugging completed July 25, 1952 19
Reason for abandonment of well or producing formation Dry Hole

If a producing well is abandoned, date of last production 19
Was permission obtained from the Conservation Division or its agents before plugging was commenced? yes

Name of Conservation Agent who supervised plugging of this well Eldon Petty
Producing formation Depth to top Bottom Total Depth of Well 3597 Feet
Show depth and thickness of all water, oil and gas formations.

OIL, GAS OR WATER RECORDS

CASING RECORD

FORMATION	CONTENT	FROM	TO	SIZE	PUT IN	PULLED OUT
				175'	8 5/8"	cemented

Describe in detail the manner in which the well was plugged, indicating where the mud fluid was placed and the method or methods used in introducing it into the hole. If cement or other plugs were used, state the character of same and depth placed, from feet to feet for each plug set.

Heavy mud from total depth of 3597 to 165 feet. Set solid plug and 15 sacks of cement. Heavy mud to 40 feet. Set another plug and 10 sacks of cement.

(If additional description is necessary, use BACK of this sheet)

Name of Plugging Contractor QUAKER DRILLING CO., INC.
Address 1100 Bitting Bldg. Wichita, Kansas

STATE OF Kansas COUNTY OF Sedgwick ss.
Thomas M. McCaul (employee of owner) or (owner or operator) of the above-described well, being first duly sworn on oath, says: That I have knowledge of the facts, statements, and matters herein contained and the log of the above-described well as filed and that the same are true and correct. So help me God.


(Signature) *Thomas M. McCaul*
1100 Bitting Bldg. Wichita, Kansas
(Address)

SUBSCRIBED AND SWORN TO before me this 25th day of July, 19 52

My commission expires

March 15 1955
STATE CORPORATION COMMISSION 24-2675-5

2.52-20M

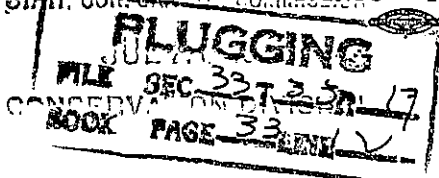

Notary Public.

WELL LOG

ALPINE OIL & ROYALTY CO., INC. Elevation: 1969 R.B.
 Contractor: Quaker Drilling Co., Inc. Commenced: 7-15-52
 Braun No. 1 Completed: 7-25-52
 NW NE NE Sec. 33-13S-17W
 Ellis County, Kansas Production: D & A

Casing Record:

Set 175' of 8 5/8" with 300 sacks

(The following figures indicate bottom of formations)

<u>FORMATIONS:</u>	<u>DEPTHS</u>	<u>FORMATION TOPS:</u>
Surface soil & Shale	50	Heebner 3227 -1258
Shale and Shells	175	Lansing 3271 -1302
Blue Shale and Shells	315	Conglomerate 3588 -1619
Sand	376	T.D. (r) 3597 -1628
Sand streaks & Pyrites & Shale	620	
Sand	785	
Shale & Shells & Red Bed	1080	
Shale and Sand and Shells	1330	
Shale and Shells	1590	
Lime and Shale	3579 T. D.	

I hereby certify that the above is a true and correct copy of Drillers' Log of well drilled in the NW NE NE of Section 33, Township 13 South, Range 17 West, Ellis County, Kansas.

QUAKER DRILLING CO., INC.

By: *James M. Cuel*
 President

Subscribed and sworn to this 25 day of July, 1952, before me the undersigned Notary Public.

Jo Ann Braun
 Notary Public

My commission Expires:
 March 7, 1955

PLUGGING
 FILE SEC. 33T 13S 17W
 BOOK PAGE 33 17

COMMISSION
 JUL 23 1952
 CONSERVATION DIVISION
 Wichita, Kansas