


STATE OF KANSAS
STATE CORPORATION COMMISSION

WELL PLUGGING RECORD

Give All Information Completely
Make Required Affidavit
Mail or Deliver Report to:
Conservation Division
State Corporation Commission
800 Bitting Building
Wichita, Kansas

Ellis County, Sec. 26 Twp. 13 Rge. (E) 17 (W)

Location as "NE/CNW $\frac{1}{4}$ SW $\frac{1}{4}$ " or footage from lines NE-NE-SW
Lease Owner John H. Wilson and Wunderlich Contracting Company
Lease Name Clarence Braun Well No. 1
Office Address 1411 Electric Building, Fort Worth 2, Texas
Character of Well (completed as Oil, Gas or Dry Hole) Dry Hole
Date well completed August 30 1949
Application for plugging filed August 30 1949
Application for plugging approved August 30 1949
Plugging commenced August 31 1949
Plugging completed August 31 1949
Reason for abandonment of well or producing formation Low and Insufficient Oil Saturation

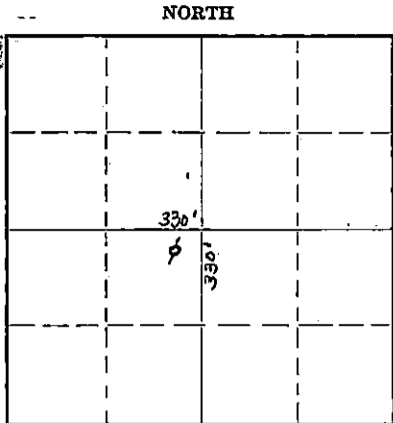

Locate well correctly on above Section Plat

If a producing well is abandoned, date of last production 19
Was permission obtained from the Conservation Division or its agents before plugging was commenced? Yes

Name of Conservation Agent who supervised plugging of this well Eldon Petty
Producing formation Arbuckle Depth to top 3506 R. Bottom 3544 R. Total Depth of Well 3544 Feet
Show depth and thickness of all water, oil and gas formations.

OIL, GAS OR WATER RECORDS

CASING RECORD

Formation	Content	From	To	Size	Put In	Pulled Out
				14"	80'	None
				8 5/8"	1156'	None

Describe in detail the manner in which the well was plugged, indicating where the mud fluid was placed and the method or methods used in introducing it into the hole. If cement or other plugs were used, state the character of same and depth placed, from.....feet to.....feet for each plug set.

3544 - 250 Heavy Rotary Mud
250 - 220 Solid Bridge and 15 sacks cement
220 - 35 Heavy Mud
35 - Surface Bridge and 10 sacks cement

RECEIVED

Conservation Div.

SEP 7 1949

9-7-49

STATE CORPORATION

COMMISSION
KANSAS

(If additional description is necessary, use BACK of this sheet)

Correspondence regarding this well should be addressed to Thos. H. Allan
Address 921 Union National Bank Building, Wichita 2, Kansas


STATE OF Kansas, COUNTY OF Sedgwick, ss.
Thos. H. Allan (employee of owner or owner or operator) of the above-described well, being first duly sworn on oath, says: That I have knowledge of the facts, statements, and matters herein contained and the log of the above-described well as filed and that the same are true and correct. So help me God.

(Signature) Thos. H. Allan

921 Union National Bank Bldg., Wichita 2, Ks.
(Address)

SUBSCRIBED AND SWORN TO before me this 3rd day of September, 19 49

My commission expires June 14, 1950

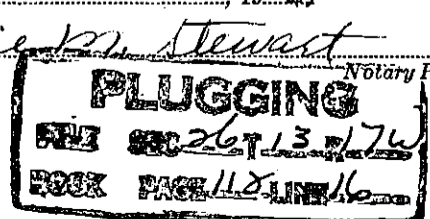

14" @ 80' - 50 sx circulated
 8 5/8" @ 1156' - 300 sx circulated

Wilson & Wunderlich #1 CLARENCE BRAUN
 NE NE SW 26-13-17W
 Ellis County, Kansas
 Comm: 8/14/49 Compl: 8/31/49
 Contractor: Tom Allan
 Elevation 1955
 I.P. Dry & Abandoned

0 - 20 soil & sand
 250 shale
 850 sand & shale
 1150 red beds
 1188 anhydrite
 1400 red beds
 1600 shale & anhydrite
 1800 shale
 1900 anhydrite
 2078 shale
 2170 lime
 2200 cherty lime
 2350 shale
 2390 lime
 2414 red shale
 2424 oolitic lime
 2952 shale & shells
 3085 lime & shale breaks
 3096 lithographic lime
 3211 lime & shale breaks
 3213 black shale
 3250 shale & lime
 3259 red shale
 3272 crystalline lime
 3280 shale
 3288 cherty lime
 3300 shale
 3313 lime
 3322 shale
 3334 lime
 3340 cherty lime & residue
 3348 lime
 3355 soft oolitic lime
 3370 lime
 3380 shale
 3390 cherty lime
 3400 lime
 3410 shale
 3434 lime
 3436 soft oolitic lime
 3482 lime
 3490 red shale
 3497 lime

3504 red shale
 3516 crystalline dolomite
 3518 dolomite, oil stained
 3523 soft dolomite (probably water)
 3542 T. D. dolomite

FORMATIONS:

1150 Top Anhydrite
 2414 Top Neva.
 3085 Top Lecompton
 3211 Top Heebner
 3259 Top Lansing
 3504 Top Arbuckle

I certify that the above is a true and correct copy of the well log on the above test.

Tom Allan

Subscribed and sworn to before me this 3rd day of September, 1949.

Clara M. Stewart
 Notary Public

My Commission expires June 14, 1950

SEP 7 X 1949

STATIONER
 COMMISSION
 KANSAS

26-13-17W
 117-16