


STATE OF KANSAS
STATE CORPORATION COMMISSION

WELL PLUGGING RECORD

Give All Information Completely
Make Required Affidavit
Mail or Deliver Report to:
Conservation Division
State Corporation Commission
800 Bitting Building
Wichita, Kansas

Ellis County. Sec. 18 Twp. 13 Rge. 17 (E) W (W)
Location as "NE/CNW%SW%" or footage from lines SE SW NE
Lease Owner V. D. Sidey Oil Company
Lease Name Ed Polifka Well No. 1
Office Address Russell, Kansas
Character of Well (completed as Oil, Gas or Dry Hole) Dry Hole
Date well completed 1-28-53 19
Application for plugging filed 1-28-53 19
Application for plugging approved 1-28-53 19
Plugging commenced 1-28-53 19
Plugging completed 1-28-53 19
Reason for abandonment of well or producing formation Dry

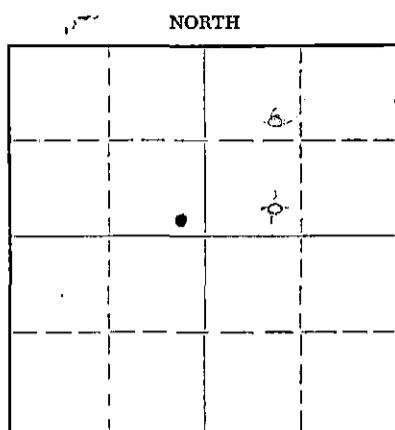

Locate well correctly on above Section Plat

If a producing well is abandoned, date of last production _____ 19
Was permission obtained from the Conservation Division or its agents before plugging was commenced? Yes

Name of Conservation Agent who supervised plugging of this well Eldon Pettie Hays, Kansas
Producing formation _____ Depth to top _____ Bottom _____ Total Depth of Well 3683' Feet
Show depth and thickness of all water, oil and gas formations.

OIL, GAS OR WATER RECORDS

CASING RECORD

FORMATION	CONTENT	FROM	TO	SIZE	PUT IN	PULLED OUT
				8 5/8"	101'	
					Cira. Cement	

Describe in detail the manner in which the well was plugged, indicating where the mud fluid was placed and the method or methods used in introducing it into the hole. If cement or other plugs were used, state the character of same and depth placed, from _____ feet to _____ feet for each plug set.

Hole was filled with heavy mud to 240' of top. Plug was set and 15 sacks cement spotted through drill pipe. Then filled to 15' of top with heavy mud and plug set 1/2 sack of hull on top of plug and hole filled with cement to bottom of cellar 10 sacks.

(If additional description is necessary, use BACK of this sheet)

Name of Plugging Contractor _____
Address _____

STATE OF KANSAS, COUNTY OF RUSSELL, ss.
V. D. Sidey (employee of owner) or (owner or operator) of the above-described well, being first duly sworn on oath, says: That I have knowledge of the facts, statements, and matters herein contained and the log of the above-described well as filed and that the same are true and correct. So help me God.

(Signature) [Handwritten Signature]
(Address) _____

SUBSCRIBED AND SWORN to before me this 3rd day of February, 19 53

My commission expires Sept. 17, 1956

[Signature]
STATE CORPORATION COMMISSION
Notary Public.

24-2675-S 2-52-20M

PLUGGING

FILE SEC 18-13-R-17W

BOOK PAGE 26 LINE 42

2-5-1953

SIDEY DRILLING COMPANY

BUILDING & LOAN BLDG. P. O. BOX 387

RUSSELL, KANSAS

COMPANY V. D. Sidey Oil Company

SEC. 18 T. 13 R. 17

FARM Ed

NO. 1

LOC. SE NW NE

TOTAL DEPTH 3683'

COUNTY Ellis

COMM. 1-16-53

COMP. 1-28-53

SHOT OR TREATED

CONTRACTOR Sidey Drilling Company

ISSUED

CASING	
20	10'
15 1/2	8 3/4 101'
12 1/2	6 5/8
13 3/8	5 5/16

ELEVATION 2131' RB

PRODUCTION D & A

FIGURES INDICATE BOTTOM OF FORMATIONS

0-50	Chalk rock	2130-2500	Lime & Shale
50-60	Shale	2500-2620	Shale & Lime
60-65	Sand	2620-2635	Lime & Shale
65-101	Shale & Shells	2635-2670	Lime & Shale
101-150	Shale & Shells	2670-2750	Lime & Shale
150-220	Shale	2750-2835	Lime & Shale
220-370	Shale & Shells	2835-2915	Lime & Shale
370-420	Shells & Shale	2915-3005	Lime & Shale
420-430	Sand & Shale	3005-3080	Lime & Shale
430-460	Shells shale & sand	3080-3185	Lime & Shale
460-530	Sand	3185-3250	Lime & Shale
530-660	Grey & Blue shale	3250-3300	Lime & Shale
660-720	Sand	3300-3360	Lime & Shale
720-770	Shale	3360-3400	Lime
770-790	Shells & shale	3400-3435	Lime
790-830	Shale	3435-3495	Lime
830-990	Sand	3495-3550	Lime
990-1030	Red Bed	3550-3590	Lime
1030-1340	Red Bed	3590-3655	Lime
1340-1370	Anhydrite	3655-3683	Lime & Shale T. D.
1370-1389	Anhydrite		
1389-1610	Shale & Shells		
1610-1750	Shale & Shells		
1750-2015	Shale & Shells		
2015-2040	Shale & Shells		
2040-2060	Salt		
2060-2140	Shale & Lime		
2140-2217	Lime & Shale		
2217-2355	Lime & Shale		
2355-2430	Lime		

STATE OF KANSAS, COUNTY OF RUSSELL, ss/

I V. D. Sidey, of the Sidey Drilling Company, upon oath state that the above and foregoing is a true and correct copy of the log of the Ed #1 Well.

CONSERVATION COMMISSION
Wichita, Kansas V. D. SIDEY

Subscribed and sworn to before me this 3rd day of February, 1953.

My Commission Expires: Sept. 17, 1956

PLUGGING
 FILE SEC 18 T 13 R 17
 BOOK PAGE 76 LINE 42

NOTARY PUBLIC