


STATE OF KANSAS
STATE CORPORATION COMMISSION

Give All Information Completely
Make Required Affidavit
Mail or Deliver Report to:
Conservation Division
State Corporation Commission
800 Bitting Building
Wichita, Kansas

WELL PLUGGING RECORD

NORTH

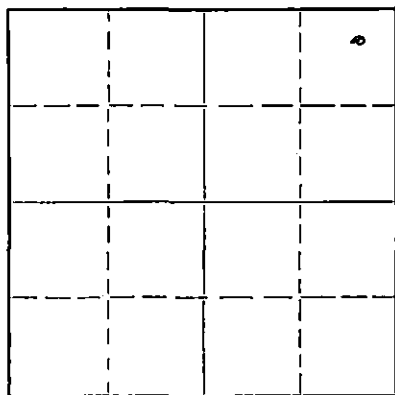

Locate well correctly on above
Section Plat

Ellis County, Sec. 15 Twp. 13 Rge. 13 (E) 17 (W)
Location as "NE/CNWKSW" or footage from lines SW NE NE
Lease Owner L. W. Garvie
Lease Name Dorzweiler Well No. 1
Office Address 425 N. Broadway Wichita, Kansas
Character of Well (completed as Oil, Gas or Dry Hole) Dry Hole
Date well completed 1-12-53 19
Application for plugging filed 1-22-53 19
Application for plugging approved 19
Plugging commenced 1-12-53 19
Plugging completed 1-12-53 19
Reason for abandonment of well or producing formation non-productive
If a producing well is abandoned, date of last production 19
Was permission obtained from the Conservation Division or its agents before plugging was commenced? yes

Name of Conservation Agent who supervised plugging of this well Eldon Petty
Producing formation none Depth to top Bottom Total Depth of Well 35-85 Feet
Show depth and thickness of all water, oil and gas formations.

OIL, GAS OR WATER RECORDS

CASING RECORD

FORMATION	CONTENT	FROM	TO	SIZE	PUT IN	PULLED OUT
				8 5/8	163'	

Describe in detail the manner in which the well was plugged, indicating where the mud fluid was placed and the method or methods used in introducing it into the hole. If cement or other plugs were used, state the character of same and depth placed, from _____ feet to _____ feet for each plug set.

Heavy mud to 163'
15 sack cement plug at 163'
heavy mud to 40'
10 sack cement Plug at 40'
weld cap on surface casing at 5'

3-26-1953

CONSERVATION DIVISION
Wichita, Kansas

(If additional description is necessary, use BACK of this sheet)
Name of Plugging Contractor Overland Drilling Company
Address Great Bend Kansas

STATE OF Kansas, COUNTY OF Barton, ss.
H. W. Tomlinson (employee of owner) or (owner or operator) of the above-described well, being first duly sworn on oath, says: That I have knowledge of the facts, statements, and matters herein contained and the log of the above-described well as filed and that the same are true and correct. So help me God.


(Signature) H. W. Tomlinson

Box 162 Great Bend Kansas (Address) 53

SUBSCRIBED AND SWORN TO before me this 25 day of March 19 53

My commission expires Dec 12th 1953

E. W. Richards
Notary Public.

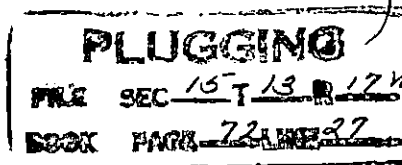

Well Log
 Overland Drilling Company
 Dorzweiler No.1 SW NE NE 15-13-17W
 Ellis County Kansas

From	To		
0	40	surface clay	Spudded 12-26-52
40	163	sand-blue shale	Casing
163	346	shale & shells	163' 8 5/8" cement circulated
346	700	" "	Plugged D. & A 1-12-53
700	825	sand	
825	1085	shale, sand, red bed	
1095	1190	red bed, shells	
1190	1225	lime, anhydrite	
1225	1415	red bed, shells	
1415	1615e, sh	shale, shells	
1615	1724	" "	
1724	1860	salt, shale, shells	
1860	1960	shale and lime shells	
1960	2175	" " " "	
2175	2223	lime	
2223	2445	"	
2445	2630	lime and shale	
2630	2937	" " "	
2937	3118	" " "	
3118	3216	lime	
3216	3222	lime and shale	
3222	3270	lime	
3270	3326	"	
3326	3479	"	
3479	3585	" (T. D.)	

Drill Stem Test at 3326
 48' anchor
 B. H. P 500 lbs.
 Recovered 94' salt water

Plugging Record

Hole bridged and cement plug at 155ft.-15 sacks cement
 10 sack cement plug at 40 ft.

