


Give All Information Completely
Make Required Affidavit
Mail or Deliver Report to:
Conservation Division
State Corporation Commission
806 Bittling Building
Wichita, Kansas

OR
FORMATION PLUGGING RECORD

Strike out upper line
when reporting plug-
ging of formations.

NORTH

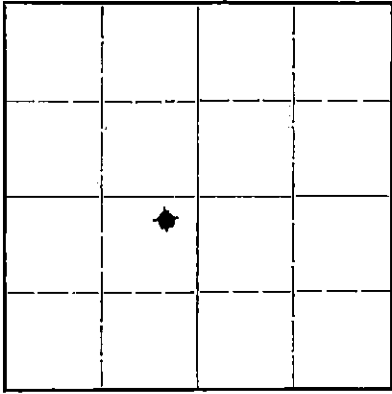

Locate well correctly on above
Section Plat

Ellis County, Sec. 4 Twp. 14 Rge. (E) 17 (W)
Location as "NE $\frac{1}{4}$ NW $\frac{1}{4}$ SW $\frac{1}{4}$ " or footage from lines. NE-SW
Lease Owner. Sunray Oil Corporation
Lease Name. Lang Well No. #1
Office Address. Box 195 Great Bend, Kansas
Character of Well (completed as Oil, Gas or Dry Hole). Dry hole
Date well completed. Nov. 21 1945
Application for plugging filed. Dec. 17 1945
Application for plugging approved. Dec. 19 1945
Plugging commenced. Dec. 28 1945
Plugging completed. Dec. 31 1945
Reason for abandonment of well or producing formation. Dry hole

If a producing well is abandoned, date of last production. 19
Was permission obtained from the Conservation Division or its agents before plugging was com-
menced? yes

Name of Conservation Agent who supervised plugging of this well. Herb. Kerr
Producing formation. Arbuckle Depth to top. 3538 Bottom. 3579 Total Depth of Well. 3579 Feet
Show depth and thickness of all water, oil and gas formations.


OIL, GAS OR WATER RECORDS

CASING RECORD

Formation	Content	From	To	Size	Put In	Pulled Out
Lsg-KC	Dry	3294	-	8 5/8	1211	none
Arbuckle	Water	3538	3579	5 1/2	3539	2557

Describe in detail the manner in which the well was plugged, indicating where the mud fluid was placed and the method or methods used in introducing it into the hold. If cement or other plugs were used, state the character of same and depth placed, from _____ feet to _____ feet for each plug set.
6 sacks cement dumped from 3579 T.D. to 3531
Hole filled with heavy mud to 350, 15 sx cement dumped from 350' to 300', mudded to 25, 10 sx. cement from 25' to bottom of cellar.

PLUGGING
FILE 4 14 R 17 W
BOOK PAGE 29 LINE 1

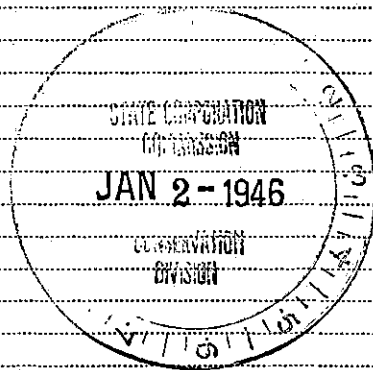

(If additional description is necessary, use BACK of this sheet)

Correspondence regarding this well should be addressed to. Sunray Oil Corporation
Address. Box 195 Great Bend, Kansas

STATE OF Kansas, COUNTY OF Barton, ss.
(employee of owner) or (owner or operator) of the above-described well,
being first duly sworn on oath, says: That I have knowledge of the facts, statements, and matters herein contained and the log of the above-described well as filed and that the same are true and correct. So help me God.

(Signature) *Fred M. Davis*
Box 195 Great Bend, Kansas
(Address)

SUBSCRIBED AND SWORN to before me this 31 day of December, 19 45

Marjorie Gunn
Notary Public.

My commission expires June 18, 1949

COMPANY: SUNRAY OIL CORPORATION

WELL: LANG #1

LOCATION: NEc SW 1/4 4-14-17
Ellis County, Kansas

Formation	Depth
Shale & shells	315
Sand	390
Shale & shells	665
Sand & shale	855
Red bed & shale	1200
Anhydrite	1230
Shale & shells	1640
Salt & shale	1860
Shale & shells	1945
Shale & lime	2300
Lime	2510
Shale & lime	2670
Lime	2740
Shale & lime	3150
Lime	3215
Broken lime	3240
Lime	3330
Lime & shale	3375
Lime	3410
Broken lime	3435
Lime	3544
TOTAL DEPTH ROTARY MEASURE	3544'

FILE 4 14-17-17
BOOK 37

JAN 16 1946