

STATE OF KANSAS  
STATE CORPORATION COMMISSION

WELL PLUGGING RECORD

GIVE All Information Completely  
Make Required Affidavit  
Mail or Deliver Report to:  
Conservation Division  
State Corporation Commission  
802 Bitting Building  
Wichita, Kansas


OR

FORMATION PLUGGING RECORD

Strike out upper line  
when reporting plug-  
ging off formations.

Ellis County. Sec. 27. Twp 14. Rge. 16 (E) W (W)  
Location as "NE 1/4 NW 1/4 SW 1/4" or footage from lines NE NE NW  
Lease Owner Homer H. Luttrell  
Lease Name Dreiling Well No. 1  
Office Address Effingham, Illinois  
Character of Well (completed as Oil, Gas or Dry Hole) Dry Hole  
Date well completed October 25, 19 47  
Application for plugging filed October 25, 19 47  
Application for plugging approved October 25, 19 47  
Plugging commenced October 25, 19 47  
Plugging completed October 25, 19 47  
Reason for abandonment of well or producing formation Dry Hole

NORTH

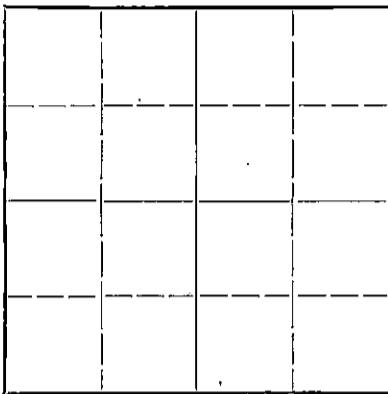

Locate well correctly on above  
Section Plat

If a producing well is abandoned, date of last production 19  
Was permission obtained from the Conservation Division or its agents before plugging was com-  
menced?

Name of Conservation Agent who supervised plugging of this well G. D. Stough, Box 105, Hays, Kansas  
Producing formation Depth to top Bottom Total Depth of Well 3410 Feet  
Show depth and thickness of all water, oil and gas formations.

OIL, GAS OR WATER RECORDS

CASING RECORD

Table with 7 columns: Formation, Content, From, To, Size, Put In, Pulled Out. The table is currently empty.

Describe in detail the manner in which the well was plugged, indicating where the mud fluid was placed and the method or methods used in introducing it into the hold. If cement or other plugs were used, state the character of same and depth placed, from feet to feet for each plug set.

Set cement plug from 3410' to 3285'. Filled hole with mud laden fluid from 3285' to 335'. Set cement plug from 335' to 210'. Set cement plug from 10' to surface.

(If additional description is necessary, use BACK of this sheet)

11-12-1947


Correspondence regarding this well should be addressed to Coppinger & Southern  
Address 1217 Union National Bank Building  
Wichita, Kansas

STATE OF Kansas, COUNTY OF Sedgwick, ss.  
W. J. Coppinger (employee of owner) or (owner or operator) of the above-described well,  
being first duly sworn on oath, says: That I have knowledge of the facts, statements, and matters herein contained and the log of the above-described well as filed and that the same are true and correct. So help me God.

(Signature) W. J. Coppinger  
1217 Union National Bank Building  
(Address)

SUBSCRIBED AND SWORN to before me this 8th day of November, 19 47

My commission expires Feb 26, 1951  
Notary Public

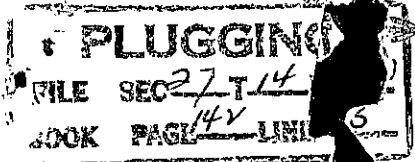

DRILLERS' LOG

Homer H. Luttrell, et al.

NE NE NW Sec. 27-14S-16W  
Ellis County, Kansas

Dreiling #1

Total Depth : 3410'  
Comm: 10-8-47  
Comp: 10-25-47  
Contractor: Coppinger & Southern

CASING RECORD:  
8 5/8" Casing set at 226' 4"  
Cemented with 150 sacks

Shale and Shells	110
Sand and Shale	228
Sand	500
Shale and iron	625
Shale and shells	901
Shale	950
Anhydrite	990
Shale and Shells	1515
Shale and Lime	1650
Lime	1745
Lime and Shale	1945
Lime	2085
Shale and Lime	2395
Shale and Shells	2470
Lime and Shale	2540
Shale	2830
Lime	2880
Lime and Shale	2940
Lime	3005
Shale	3080
Lime	3287
Lime and Shale	3312
Lime	3410

Total Depth 3410 D & A

STATE OF K a n s a s, COUNTY OF S e d g w i c k ss

I, the undersigned, being duly sworn, on oath, state that the above statement and log is a true and correct record and log of the well drilled at the location above described.

**PLUGGING**  
FILE SEC 27-14-R-160  
BOOK PAGE 42 LINE 35

COPPINGER & SOUTHERN

By [Signature]

Subscribed and sworn to before me, this 07th day of November, 1947.

My commission expires: February 26/1951

[Signature]  
Notary Public