


STATE OF KANSAS  
STATE CORPORATION COMMISSION

Give All Information Completely  
Make Required Affidavit  
Mail or Deliver Report to:  
Conservation Division  
State Corporation Commission  
800 Bittling Building  
Wichita, Kansas

WELL PLUGGING RECORD

NORTH

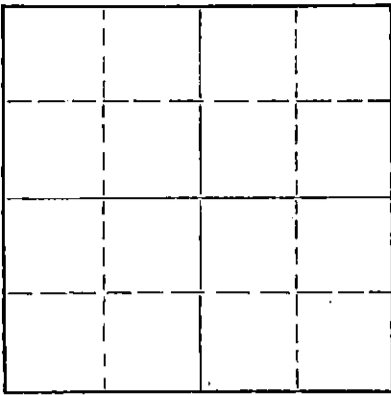

Locate well correctly on above  
Section Plat

Ellis County, Sec. 4 Twp. 14S Rge. 19 (E) W (W)  
Location as "NE/CNW/SW" or footage from lines SW NE NE  
Lease Owner Thunderbird Drilling, Inc.  
Lease Name Carl Orth Well No. 1  
Office Address 1311 Union Nat'l Bank Bldg. Wichita, Ks.  
Character of Well (completed as Oil, Gas or Dry Hole) Dry Hole  
Date well completed June 8 1955  
Application for plugging filed June 8 1955  
Application for plugging approved June 8 1955  
Plugging commenced June 8 1955  
Plugging completed June 8 1955  
Reason for abandonment of well or producing formation Dry Hole

If a producing well is abandoned, date of last production - - - - -19  
Was permission obtained from the Conservation Division or its agents before plugging was commenced? Yes

Name of Conservation Agent who supervised plugging of this well Eldon Petty  
Producing formation \_\_\_\_\_ Depth to top \_\_\_\_\_ Bottom \_\_\_\_\_ Total Depth of Well 3858' Feet  
Show depth and thickness of all water, oil and gas formations.

OIL, GAS OR WATER RECORDS

CASING RECORD

FORMATION	CONTENT	FROM	TO	SIZE	PUT IN	PULLED OUT
		191' of	8 5/8"	Surface Casing		
		cemented with		125 sacks cement		
		No Oil String				

Describe in detail the manner in which the well was plugged, indicating where the mud fluid was placed and the method or methods used in introducing it into the hole. If cement or other plugs were used, state the character of same and depth placed, from \_\_\_\_\_ feet to \_\_\_\_\_ feet for each plug set.

Hole filled to 175' with heavy mud  
Halliburton Plug with 1/3 sack hulls  
and 20 sacks cement. Filled hole to  
35'. Plug with 1/2 sack hulls and  
10 sacks cement.

6-17-1955  
RECEIVED  
STATE CORPORATION COMMISSION  
JUN 17 1955

CONSERVATION DIVISION  
Wichita, Kansas

(If additional description is necessary, use BACK of this sheet)  
Name of Plugging Contractor Thunderbird Drilling, Inc.  
Address 1311 Union Nat'l Bank Bldg., Wichita, Kansas

STATE OF Kansas, COUNTY OF Sedgwick, ss.  
Charles W. Aikins, Jr., (employee of owner) or (owner or operator) of the above-described well, being first duly sworn on oath, says: That I have knowledge of the facts, statements, and matters herein contained and the log of the above-described well as filed and that the same are true and correct. So help me God.

(Signature) Charles W. Aikins, Jr. Pres.  
1311 Union Nat'l Bank Bldg., Wichita, Ks.  
(Address)

SUBSCRIBED AND SWORN to before me this 14th day of June, 19 55

My commission expires August 25, 1956

Leta Helm  
Notary Public.

PLUGGING  
FILE REC 4 T 14 R 19W  
BOOK PAGE 126 LINE 31

## CARL ORTH #1

LOCATION: SW NE NE  
Sec. 4, 14.S, 19.W  
Ellis County, Kansas

CONTRACTOR: Thunderbird Drilling, Inc.  
1311 Union Nat'l Bank Bldg.  
Wichita, Kansas

SURFACE CSG: 191' of 8 5/8" Surface  
Casing cemented with 125 sacks  
cement.

OIL STRING: None

ELEVATION 2192' Kelly Bushing  
2189' Derrick Floor  
2187' Ground Level

COMMENCED: May 31, 1955

COMPLETED: June 8, 1955

## WELL LOG

0	-	185	Mud & Cement
185	-	575	Shale
575	-	650	Sand
650	-	1950	Shale
950	-	1150	Sand
1150	-	1270	Shale
1270	-	1485	Shale & Shells
1485	-	1515	Anhydrite
1515	-	2060	Shale and shells
2060	-	2145	Brown Lime
2145	-	2460	Broken Lime
2460	-	3400	Lime and shale
3400	-	3770	Lime
3770	-	3820	Lime and shale
3820	-	3853	Shale and chert
3853	-	3858	Lime
3858			Rotary Total Depth

The undersigned, Charles W. Aikins, Jr., an officer of Thunderbird Drilling, Inc., hereby certifies that the above is a true and correct log of the formations encountered in the drilling of the Carl Orth #1 as shown in the daily drilling reports.

THUNDERBIRD DRILLING, INC.

Charles W. Aikins, Jr., Pres.

Subscribed and sworn to before me this 14th  
day of June, 1955.

Leta Helm Notary Public

My commission expires:  
August 25, 1956

RECEIVED  
STATE CORPORATION COMMISSION  
JUN 17 1955  
CONSERVATION DIVISION  
Wichita, Kansas

PLUGGING  
FILE SEC 4 T 14 R 19W  
BOOK PAGE 126 LINE 31