


WELL PLUGGING RECORD

Give All Information Completely  
Make Required Affidavit  
Mail or Deliver Report to:  
Conservation Division  
State Corporation Commission  
211 No. Broadway  
Wichita, Kansas

NORTH

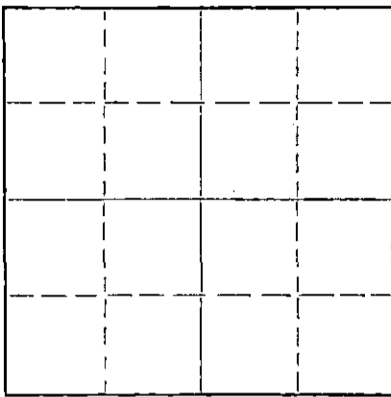

Locate well correctly on above  
Section Plat

Ellis County. Sec. 33 Twp. 14 Rge. 18 (E) W (W)

Location as "NE/CNW/SW" or footage from lines. NW NW SW

Lease Owner Tomlinson & Kathol

Lease Name Engel #1 Well No.

Office Address Wichita, Kansas

Character of Well (completed as Oil, Gas or Dry Hole)

Date well completed 19

Application for plugging filed 19

Application for plugging approved 19

Plugging commenced 9-9-57 19

Plugging completed 9-11-57 19

Reason for abandonment of well or producing formation

If a producing well is abandoned, date of last production 19

Was permission obtained from the Conservation Division or its agents before plugging was commenced? yes

Name of Conservation Agent who supervised plugging of this well Eldon Petty

Producing formation Depth to top Bottom Total Depth of Well 3704 Feet

Show depth and thickness of all water, oil and gas formations.

OIL, GAS OR WATER RECORDS

CASING RECORD

FORMATION	CONTENT	FROM	TO	SIZE	PUT IN	PULLED OUT
				8-5/8"	277'	None
				5 1/2"	3600'	3104'

Describe in detail the manner in which the well was plugged, indicating where the mud fluid was placed and the method or methods used in introducing it into the hole. If cement or other plugs were used, state the character of same and depth placed, from feet to feet for each plug set.

Checked the hole to 3704' and found it open.  
Filled w/sand to 3300' and ran 4 sacks of  
cement. Pulled pipe to approx. 1100', cir-  
culated oil and water out of hole with 40  
sacks of gel mud. Pulled pipe to 500',  
Pumped in 35 sacks of cement, pulled pipe  
XXXXXXXXXXXXXXXXXXXX to 265', pumped  
in 25 sacks of cement. Pulled pipe out of  
hole, set a rock bridge at 35' and ran 10  
sacks of cement to base of collar.

(If additional description is necessary, use BACK of this sheet)

Name of Plugging Contractor West Supply Co., Inc.

Address Chase, Kansas

STATE OF KANSAS, COUNTY OF RICE, ss.

(employee or owner) or (owner or operator) of the above-described well, being first duly sworn on oath, says: That I have knowledge of the facts, statements, and matters herein contained and the log of the above-described well as filed and that the same are true and correct. So help me God.

(Signature) Errol D. Kathol


(Address)

SUBSCRIBED AND SWORN TO before me this 13th day of September, 19 57

My commission expires 9-27-58

Thomas V. Sappin

Notary Public.

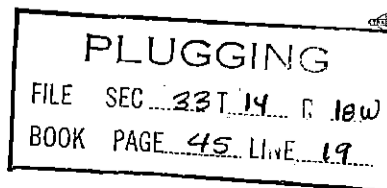

RECEIVED  
STATE CORPORATION COMMISSION

SEP 17 1957  
CONSERVATION DIVISION  
9-9-1957