

STATE OF KANSAS
STATE CORPORATION COMMISSION

WELL PLUGGING RECORD

All Information Completely
Make Required Affidavit
Mail or Deliver Report to:
Conservation Division
State Corporation Commission
800 Bittling Building
Wichita, Kansas

Ellis

County. Sec. 28 Twp. 14S Rge. (E) 17 (W)

Location as "NE/CNW 1/4 SW 1/4" or footage from lines Ctr. NE/4 NE/4 SW/4

Lease Owner Lion Oil Company

Lease Name Peter Well No. 1

Office Address P. O. Box 639, Pratt, Kansas

Character of Well (completed as Oil, Gas or Dry Hole) Dry Hole

Date well completed 7-30 19 51

Application for plugging filed 1-15 19 52

Application for plugging approved 1-15 19 52


Plugging commenced 1-15 19 52

Plugging completed 1-17 19 52

Reason for abandonment of well or producing formation Dry Hole

If a producing well is abandoned, date of last production 19

Was permission obtained from the Conservation Division or its agents before plugging was commenced? Yes

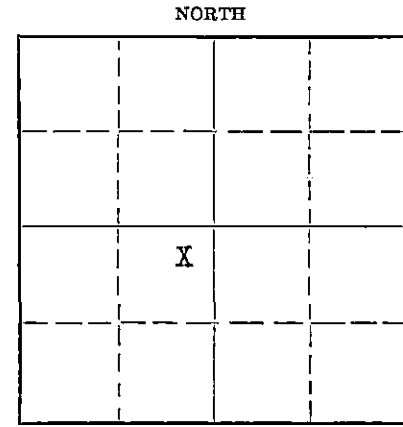

Locate well correctly on above
Section Plat

Name of Conservation Agent who supervised plugging of this well Eldon Petty

Producing formation Depth to top Bottom Total Depth of Well 3500 Feet

Show depth and thickness of all water, oil and gas formations.

OIL, GAS OR WATER RECORDS

CASING RECORD

Formation	Content	From	To	Size	Put In	Pulled Out
				8 5/8"	1120'	None
				5 1/2"	3491'	2614'

Describe in detail the manner in which the well was plugged, indicating where the mud fluid was placed and the method or methods used in introducing it into the hole. If cement or other plugs were used, state the character of same and depth placed, from feet to feet for each plug set.

Rocked hole with chat from 3500' to 3480' and ran 4 sacks of cement. Cleared hole. Mudded hole to 300', set 10' rock bridge and ran 20 sacks of cement. Mudded hole to 40', set 10' rock bridge and ran 10 sacks of cement. Plugging completed.

(If additional description is necessary, use BACK of this sheet)

Name of Plugging Contractor West Supply Company
Address Chase, Kansas

STATE OF Kansas COUNTY OF Pratt, ss.
Vernon Hayes (employee of owner)

being first duly sworn on oath, says: That I have knowledge of the facts, statements, and matters herein contained and the log of the above-described well as filed and that the same are true and correct. So help me God.

(Signature) Vernon Hayes

P. O. Box 639, Pratt, Kansas
(Address)

SUBSCRIBED AND SWORN to before me this 21st day of January, 19 52

My commission expires August 29, 1955 Notary Public.

PLUGGING
FILE SEC 28 T 14 R 2 W
BOOK PAGE 139 LINE 18

23-8390-s

6-51-20M

1-26-1952

WELL LOG

Lion Oil Company
Pratt, Kansas

NE NE SW
SEC. 28-14-17
Ellis County, Kansas

Peter #1

Total Depth: 3500'
Commenced: 7-10-51 Completed: 7-23-51
Contractor: Garvey Drilling Company
Rotary: 0 - 3500'

Casing record: 1122' of 8-5/8" surface casing set @ 1120'
 cemented w/ 550 sacks bulk cement and 2% gel
 & 2 sacks of calcium chloride, cement circulated.

Formations

Shale and Shells	0 - 85	
Sand Streaks	85 - 105	
Shale and Shells	105 - 235	
Sand	235 - 258	
Shale and Shells	258 - 400	
Shale and Shells	400 - 515	
Shale and Shells	515 - 540	
Sand	540 - 750	
Red Bed	750 - 790	
Red Bed Shells	790 - 875	
Red Bed	875 - 990	
Red Bed and Iron	990 - 1113	
Anhydrite	1113 - 1120	
Anhydrite	1120 - 1145	
Shale and Shells	1145 - 1560	
Shale and Shells	1560 - 1920	
Lime and Shale	1920 - 2105	
Lime and Shale	2105 - 2220	
Lime and Shale	2220 - 2280	
Lime and Shale	2280 - 2405	
Lime and Shale	2405 - 2535	
Lime and Shale	2535 - 2660	
Lime and Shale	2660 - 2795	
Lime and Shale	2795 - 2945	
Lime and Shale	2945 - 3057	
Lime	3057 - 3105	
Lime	3105 - 3160	
Lime	3160 - 3203	
Lime	3203 - 3255	
Lime	3255 - 3310	
Lime	3310 - 3346	
Lime	3346 - 3388	
Lime	3388 - 3425	
Lime	3425 - 3464	
Lime and Shale	3464 - 3493	
Lime	3493 - 3496	
Arbuckle	3496 - 3500 T.D.	

Tops: (Drillers)

Anhydrite	1120
Conglomerate	3482
Arbuckle	3496

We certify this to be an accurate and correct log of the above described well as shown on the Daily Drilling Reports.

GARVEY DRILLING COMPANY

FILE SEC 28-14-17
PAGE 139

Claude W. Bard
Claude W. Bard
Drilling Supt.

Subscribed and sworn to before me this 24th day of January, 1952.

My commission expires April 4, 1955

Peggy L. Shank