


WELL PLUGGING RECORD

STATE OF KANSAS
 STATE CORPORATION COMMISSION
 Give All Information Completely
 Make Required Affidavit
 Mail or Deliver Report to:
 Conservation Division
 State Corporation Commission
 800 Bitting Building
 Wichita, Kansas

OR
FORMATION PLUGGING RECORD Strike out upper line when reporting plugging of formations.

Ellis County. Sec. 24 Twp. 14 Rge. 17 (E) (W)
 Location as "NE $\frac{1}{4}$ NW $\frac{1}{4}$ SW $\frac{1}{4}$ " or footage from lines. NW - NW - SW
 Lease Owner: Great Lakes Carbon Corporation
 Lease Name: Gerstner Well No. 1
 Office Address: 501 Petroleum Bldg., Wichita, Kansas
 Character of Well (completed as Oil, Gas or Dry Hole): Dry Hole
 Date well completed: 12-29-52 19.
 Application for plugging filed: 12-29-52 19.
 Application for plugging approved: 12-29-52 19.
 Plugging commenced: 12-29-52 19.
 Plugging completed: 12-30-52 19.
 Reason for abandonment of well or producing formation: Dry Hole

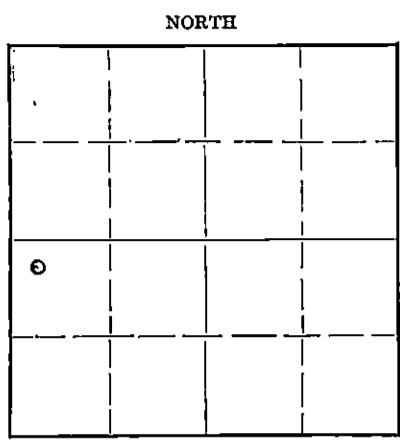

Locate well correctly on above Section Plat

If a producing well is abandoned, date of last production: 19.
 Was permission obtained from the Conservation Division or its agents before plugging was commenced? Yes

Name of Conservation Agent who supervised plugging of this well: Eldon Petty, Hays, Kansas
 Producing formation: Depth to top: Bottom: Total Depth of Well: Feet
 Show depth and thickness of all water, oil and gas formations.

OIL, GAS OR WATER RECORDS

CASING RECORD

Formation	Content	From	To	Size	Put In	Pulled Out
None				13-3/8"	160	0
				8-5/8"	1087	0

Describe in detail the manner in which the well was plugged, indicating where the mud fluid was placed and the method or methods used in introducing it into the hole. If cement or other plugs were used, state the character of same and depth placed, from _____ feet to _____ feet for each plug set.

Heavy Rotary Mud 3500 to 300'
 Halliburton Plug at 300
 1/2 sack hullsa on top of plug
 20 sacks cement 300 to 240'
 Heavy mud 240 to 40'
 Halliburton plug at 40
 1/2 sack hulls on top of plug
 15 sacks cement 40 to 6' cellar

12-31-1952
 RECEIVED
 CONSERVATION DIVISION
 DEC 31 1952
 CONSERVATION DIVISION
 Wichita, Kansas

(If additional description is necessary, use BACK of this sheet)
 Correspondence regarding this well should be addressed to: Great Lakes Carbon Corporation
 Address: 501 Petroleum Bldg., Wichita 2, Kansas

STATE OF KANSAS, COUNTY OF SEDGWICK, ss.
 I, D. H. Sholtus (employee of owner) or ~~owner~~ of the above-described well, being first duly sworn on oath, says: That I have knowledge of the facts, statements, and matters herein contained and the log of the above-described well as filed and that the same are true and correct. So help me God.
 (Signature) *D. H. Sholtus* Dist. Prod. Supt.
 501 Petroleum Bldg., Wichita, Kansas (Address)

SUBSCRIBED AND SWORN to before me this 30th day of December, 19 52

My commission expires January 22, 1955
Jack S. Shearston Notary Public.

22-2625 2-48-15M
PLUGGING
 FILE SEC 24 T 14 R 172
 BOOK PAGE 69 LINE 34

Well Log.

Great Lakes Carbon Corporation
 Gerstner Well No. 1.
 Total Depth 3500'
 Drilling Comm. Dec. 9, 1952
 Drilling Comp. Dec. 29, 1952
 Drilling Contractor, H. M. Williams

Sec. 24 T. 14S. R. 17W.
 NW/4 NW/4 SW/4
 Ellis County, Kansas.
 Casing:
 13 3/8" 160' 75 Sacks Cement
 8 5/8" 1089' 500 " "
 Production: Dry.

Figures indicate bottom of formations.

Shale	35	
Sand and Shells	60	
Sand & Shale	157	
Shale & Shells	280	
Sand & Shells	490	
D. Sand	710	
Shale & Shells	820	
Red Bed	1050	Top Anhydrite 1050
Anhydrite	1085	
Red Rock	1320	
Shale & Shells	1725	
Salt & Shale	1790	
Shale & Shells	1925	
Shale & Lime	2300	Top Fort Riley 2175
Lime	2336	
Lime & Shale	2625	
Shale	2650	
Lime	2658	
Shale	2690	
Shale & Shells	2797	
Shale & Sand	2910	
Lime & Shale	3016	
Lime	3079	
Lime & Shale	3113	
Lime	3147	
Lime & Shale	3187	
Lime	3500	Top Arbuckle Lime 3496
Total Depth	3500	Rotary Bushing.

Drill Stem Test at 3243 20' Mud
 " " " at 3475 15' Mud
 " " " at 3496
 Electric Log at 1050'

RECEIVED
 CORPORATION COMMISSION
 JAN 2 1953
 CONSERVATION DIVISION
 Wichita, Kansas

STATE OF KANSAS)
 COUNTY OF SEDGWICK) SS.

This is to certify that this is a true and correct copy of the
 drillers log of the above well.

H. M. Williams

Subscribed and sworn to before me, a Notary Public, this 2nd day
 of January, 1953.

My commission expires:
 Feb. 2, 1953.

R. P. Conway
 Notary Public.

PLUGGING
 BK SEC 24 T 14 R 17W
 BOOK PAGE 69 LINE 34