


STATE OF KANSAS
STATE CORPORATION COMMISSION

WELL PLUGGING RECORD

Give information Completely
Make required Affidavit
Mail deliver Report to:
Conservation Division
State Corporation Commission
211 No. Broadway
Wichita, Kansas

Ellis County. Sec. 14 Twp. 14, Rge. (E) 20 (W)
Location as "NE/CNW&SW" or footage from lines NE NW NW
Lease Owner Thunderbird Drilling, Inc.
Lease Name Cerney Well No. 1
Office Address 712 Union Center, Wichita, Kansas
Character of Well (completed as Oil, Gas or Dry Hole) Dry Hole
Date well completed January 3, 1957
Application for plugging filed January 3, 1957
Application for plugging approved January 3, 1957
Plugging commenced January 3, 1957
Plugging completed January 3, 1957
Reason for abandonment of well or producing formation Dry Hole

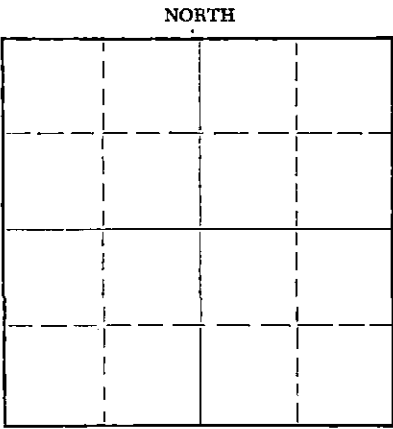

Locate well correctly on above
Section Plat

If a producing well is abandoned, date of last production 19____
Was permission obtained from the Conservation Division or its agents before plugging was commenced? Yes

Name of Conservation Agent who supervised plugging of this well Mr. Eldon Petty
Producing formation _____ Depth to top _____ Bottom _____ Total Depth of Well 3840 Feet
Show depth and thickness of all water, oil and gas formations.

OIL, GAS OR WATER RECORDS

CASING RECORD

FORMATION	CONTENT	FROM	TO	SIZE	PUT IN	PULLED OUT
		0	298'	8 5/8"		

Describe in detail the manner in which the well was plugged, indicating where the mud fluid was placed and the method or methods used in introducing it into the hole. If cement or other plugs were used, state the character of same and depth placed, from _____ feet to _____ feet for each plug set.

Bottom plug at 180 feet with 1/2 sack hulls and 20 sacks of cement mixed and poured through drillpipe. Hole filled with heavy mud to 40 feet, set HOWCO plug with 1/2 sack hulls and 10 sacks cement.

(If additional description is necessary, use BACK of this sheet)

Name of Plugging Contractor Thunderbird Drilling, Inc.
Address 712 Union Center, Wichita, Kansas

STATE OF KANSAS, COUNTY OF SEDGWICK, ss.
Charles W. Aikins, Jr., Pres. (employee of owner) or (owner or operator) of the above-described well, being first duly sworn on oath, says: That I have knowledge of the facts, statements, and matters herein contained and the log of the above-described well as filed and that the same are true and correct. So help me, God.

(Signature) Charles W. Aikins, Jr.
712 Union Center, Wichita, Kansas (Address)

SUBSCRIBED AND SWORN TO before me this 4th day of January, 1957

Jenell Schartz Notary Public.

My commission expires _____

PLUGGING
FILE SEC 14 T 14 R 20W
BOOK PAGE 131 L 30

RECEIVED
JENELL SCHARTZ, Notary Public
My Commission Expires Sept. 5, 1960

1-9-1957
CONSERVATION DIVISION
Wichita

THUNDERBIRD DRILLING, INC.

#1 CERNEY

LOCATION: NE NW NW - Sec. 14,
Twp. 14.S, Rge 20.W
Ellis County, Kansas

CONTRACTOR: Thunderbird Drilling, Inc.
712 Union Center
Wichita, Kansas

SURFACE CASING: 8 5/8" set at 298' with 150 sacks
of cement, 1 1/2% gel and 2 sacks
Calcium Chloride.

OIL STRING: None

ELEVATION: 2152' K. B.
2149' D. F.
2147' G. L.

COMMENCED: December 18, 1956

COMPLETED: January 3, 1957

WELL LOG

0 - 163	Surface Clay & Shale & Rock
163 - 560	Shale
560 - 910	Sand
910 - 1110	Shale & Sand
1110 - 1175	Sand
1175 - 1450	Shale & Shells
1450 - 1490	Anhydrite
1490 - 1806	Shale & Shells
1806 - 2990	Shale & Lime
2990 - 3000	Lime
3000 - 3265	Shale & Lime
3265 - 3705	Lime
3705 - 3760	Shale & Lime
3760 - 3780	Cherty Lime
3780 - 3800	Shale & Lime
3800 - 3805	Shale & Sand
3805 - 3840	Sand
3840	Rotary Total Depth

The undersigned, Charles W. Aikins, Jr., an officer of Thunderbird Drilling, Inc., hereby certifies that the above is a true and correct log of the formations encountered in the drilling of the #1 Cerney as shown in the daily drilling reports.

THUNDERBIRD DRILLING, INC.

[Handwritten Signature]
Charles W. Aikins, Jr., Pres.

Subscribed and sworn to before me
this 4th day of January, 1957.

[Handwritten Signature]

JENELL SCHARTZ, Notary Public
My Commission Expires Sept. 5, 1960

RECEIVED
STATE CORPORATION COMMISSION

JAN 9 X 1957

CONSERVATION DIVISION
Wichita, Kansas

PLUGGING
FILE SEC 14 T 14 R 20W
BOOK PAGE 131 L F 30