

WELL PLUGGING RECORD


FORMATION PLUGGING RECORD

STATE OF KANSAS STATE CORPORATION COMMISSION

Give All Information Completely Make Required Affidavit Main or Detail Report to: Conservation Division State Corporation Commission 800 Bittling Building Wichita, Kansas

Strike out upper line when reporting plugging of formations.

Ellis County Sec. 3 Twp. 14S Rge. 20 (E) (W) Location as "NE 1/4 NW 1/4 SW 1/4" or footage from lines SE NE SE Lease Owner White Eagle Oil Company Lease Name Dinkel Well No. 1 Office Address 415 Philtower Building, Tulsa 3, Oklahoma Character of Well (completed as Oil, Gas or Dry Hole) Dry Hole Date well completed 6-19 19 49 Application for plugging filed 6-19 19 49 Application for plugging approved 6-19 19 49 Plugging commenced 6-19 19 49 Plugging completed 6-20 19 49 Reason for abandonment of well or producing formation Dry Hole If a producing well is abandoned, date of last production --- 19 Was permission obtained from the Conservation Division or its agents before plugging was commenced? Yes

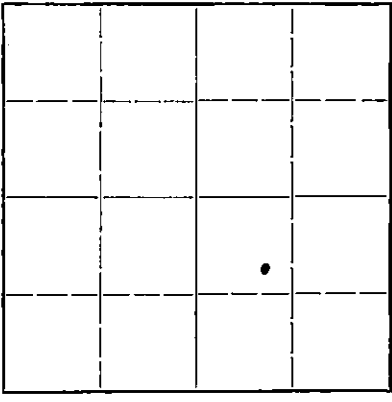

Locate well correctly on above Section Plat

Name of Conservation Agent who supervised plugging of this well M. A. Rives Producing formation - Depth to top - Bottom - Total Depth of Well 3922 Feet Show depth and thickness of all water, oil and gas formations.

OIL, GAS OR WATER RECORDS Elevation DF 2248 CASING RECORD

Table with 7 columns: Formation, Content, From, To, Size, Put In, Pulled Out. Rows include Heebner, Dedds Lime, Lansing - K.C., Conglomerate, Arbuckle, Reagan.

Describe in detail the manner in which the well was plugged, indicating where the mud fluid was placed and the method or methods used in introducing it into the hole. If cement or other plugs were used, state the character of same and depth placed, from...feet to...feet for each plug set.

Hole full heavy drilling mud. Bottom plug set at 225' cemented with 20 sacks cement by Halliburton. Second plug at 25' cemented with 10 sacks cement - surface capped.

U-29-49 RECEIVED Conservation Div. JUN 29 1949 STATE CORPORATION COMMISSION KANSAS


(If additional description is necessary, use BACK of this sheet) Correspondence regarding this well should be addressed to Helmerich & Payne, Inc. Address 415 Philtower Building, Tulsa 3, Oklahoma

STATE OF Oklahoma, COUNTY OF Tulsa, ss. (employee of owner) or (owner or operator) of the above-described well, being first duly sworn on oath, says: That I have knowledge of the facts, statements, and matters herein contained and the log of the above-described well as filed and that the same are true and correct. So help me God.

(Signature) Harry Saye 415 Philtower Bldg., Tulsa 3, Oklahoma (Address)

SUBSCRIBED AND SWORN to before me this 27th day of June, 19 49 My Commission Expires Aug. 29, 1951

Notary Public signature

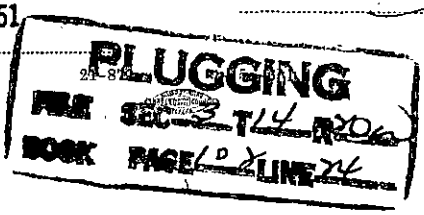

My commission expires

Dinkel No. 1 Well  
SE/4 NE/4 SE/4 Section 3-14S-20W  
Ellis County, Kansas  
White Eagle Oil Company

Commenced: June 1, 1949  
 Completed: June 19, 1949

Surface clay and caliche	0	40
Shale, shells, sand	40	540
Shale, lime	540	800
Shale, lime shells, pyrite	800	915
Shale, shells and sand	915	1240
Shale	1240	1280
Anhydrite	1280	1284
Shale, sand, lime shells	1284	1635
Shale, lime	1635	2165
Lime and shale	2165	2280
Lime	2280	2325
Lime, shale	2325	2350
Shale, lime	2350	2400
Shale	2400	2500
Sandy lime	2500	2545
Shale, lime	2545	3595
Lime	3595	3648
Lime and shale	3648	3668
Lime	3668	3834
Shale, sand	3834	3844
Lime	3844	3922
 TOTAL DEPTH	 3922	

CASING RECORD

Set 8 5/8" casing at 1284' with 700 sacks.

STATE OF OKLAHOMA )  
 ) ss  
 COUNTY OF TULSA )

I hereby affirm that the above and foregoing is a true and correct copy of the log of our Dinkel No. 1 Well, located in the Southeast Quarter of the Northeast Quarter of the Southeast Quarter of Section 3, Township 14 South, Range 20 West, Ellis County, Kansas.

HELMRICH & PAYNE, INC.

By William D. Payne  
 Treasurer

Subscribed and sworn to before me, a Notary Public, this 28th day of June, 1949

W. H. Blythe  
 Notary Public

My commission expires March 13, 1950.

RECEIVED

Oil & Gas Div.

JUN 29 1949

STATE CORPORATION  
 COMMISSION  
 KANSAS

LOGGING  
 SE/4 NE/4 SE/4 20W  
 BOOK PAGE 107 LINE 74