


STATE OF KANSAS  
STATE CORPORATION COMMISSION

Give All Information Completely  
Make Required Affidavit  
Mail or Deliver Report to:  
Conservation Division  
State Corporation Commission  
809 Bittling Building  
Wichita, Kansas

WELL PLUGGING RECORD

Ellis County, Sec. 32 Twp. 12S Rge. (E) 20 (W)  
Location as "NE/CNW/SWK" or footage from lines C - SW 1/4 SE 1/4 SE 1/4  
Lease Owner Lion Oil Company  
Lease Name Shubert Well No. 1  
Office Address P. O. Box 639, Pratt, Kansas  
Character of Well (completed as Oil, Gas or Dry Hole) Dry Hole  
Date well completed 8-29 1953  
Application for plugging filed 8-29 1953  
Application for plugging approved 8-29 1953  
Plugging commenced 8-29 1953  
Plugging completed 8-29 1953  
Reason for abandonment of well or producing formation Dry Hole

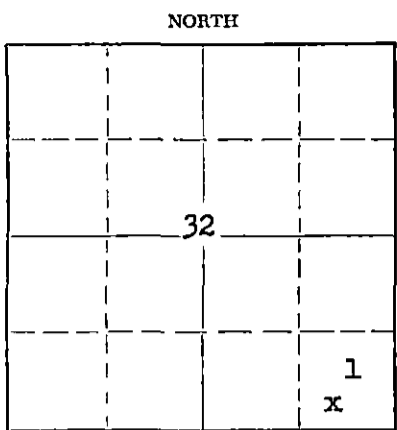

Locate well correctly on above Section Plat

If a producing well is abandoned, date of last production 19  
Was permission obtained from the Conservation Division or its agents before plugging was commenced? Yes

Name of Conservation Agent who supervised plugging of this well Mr. Eldon Petty  
Producing formation Depth to top Bottom Total Depth of Well 3858 Feet  
Show depth and thickness of all water, oil and gas formations.

OIL, GAS OR WATER RECORDS

CASING RECORD

| FORMATION | CONTENT | FROM | TO | SIZE   | PUT IN | PULLED OUT |
|-----------|---------|------|----|--------|--------|------------|
|           |         |      |    | 8-5/8" | 205'   | 0          |
|           |         |      |    |        |        |            |
|           |         |      |    |        |        |            |
Describe in detail the manner in which the well was plugged, indicating where the mud fluid was placed and the method or methods used in introducing it into the hole. If cement or other plugs were used, state the character of same and depth placed, from feet to feet for each plug set.

Plugged back with mud from 3858' to 195'.  
Set first wooden plug. Placed 1/2 sack  
hulls ahead of 15 sacks cement through drill  
pipe onto plug @ 195'. Mudded up to 40' and  
set second wooden plug. Filled hole to top  
of surface pipe with 10 sacks of cement.

STATE CORPORATION COMMISSION  
9-8-53  
CONSERVATION DIVISION  
Wichita, Kansas


(If additional description is necessary, use BACK of this sheet)  
Name of Plugging Contractor Garvey Drilling Company  
Address 305 East Third, Wichita, Kansas

STATE OF KANSAS, COUNTY OF PRATT, ss.  
Joe Costello (employee of owner) of the above-described well, being first duly sworn on oath, says: That I have knowledge of the facts, statements, and matters herein contained and the log of the above-described well as filed and that the same are true and correct. So help me God.

(Signature) Joe Costello  
P. O. Box 639, Pratt, Kansas (Address)

SUBSCRIBED AND SWORN TO before me this 5th day of September 19 53  
Dan Deubek Notary Public.

My commission expires August 29, 1955

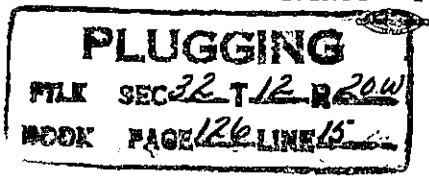

DRILLER'S LOG SHEET NO. 1

Lion Oil Company, Operator

Section 32, Twp. 12S, Rge. 20W

Garvey Drilling Company, Contractor

Location: SW SE SE

Drilling Commenced: August 18, 1953

County: Ellis County, Kansas

Drilling Completed: August 29, 1953

Production: D & A

Casing Record: 8 5/8" @ 205' w/135 sax

R.T.D.: 3858'

Elevation: 2159' R.B.

Figures below indicate bottom of formation:

|      |                |
|------|----------------|
| 205  | Shale          |
| 935  | Shale & Shells |
| 1220 | Sand           |
| 2020 | Shale & Shells |
| 3415 | Lime & Shale   |
| 3858 | Lime           |
| 3858 | R.T.D.         |

Tops:

|               |      |
|---------------|------|
| Heebner:      | 3322 |
| Lansing:      | 3450 |
| Conglomerate: | 3798 |
| Arbuckle:     | 3847 |

I hereby certify that this is a true and correct log of the above mentioned well.

GARVEY DRILLING COMPANY

by W. W. Fisher

RECEIVED  
STATE OF KANSAS COMMISSION  
NOTARY PUBLIC  
STATE OF KANSAS  
COMMISSION EXPIRES  
OCTOBER 13, 1954

STATE OF KANSAS )  
                          ) SS:  
COUNTY OF SEDGWICK)

Subscribed to and sworn to before me, a Notary Public, in said County and State, this 2nd day of September, 1953.

**PLUGGING**  
FILE SEC 32 T 12 R 20 W  
BOOK PAGE 126 LINE 15

Sharon Heidman  
Notary Public

My commission expires: October 13, 1954.