

15.051.01148.00.00

STATE OF KANSAS
STATE CORPORATION COMMISSION

WELL PLUGGING RECORD


Give All Information Completely
Make Required Affidavit
Mail or Deliver Report to:
Conservation Division
State Corporation Commission
800 Bitting Building
Wichita, Kansas

OR
FORMATION PLUGGING RECORD

Strike out upper line
when reporting plug-
ging of formations.

Ellis County. Sec. 32 Twp. 12 Rge. X 20 (W)

Location as "NE 1/4 NW 1/4 SW 1/4" or footage from lines. SE SE SE
Lease Owner: Doley Oil Co.
Lease Name: Shubert
Office Address: Hays, Kansas
Character of Well (completed as Oil, Gas or Dry Hole): Dry Hole
Date well completed: 6/10 1946
Application for plugging filed: 6/10 1946
Application for plugging approved: 6/10 1946
Plugging commenced: 6/10 1946
Plugging completed: 6/10 1946
Reason for abandonment of well or producing formation:

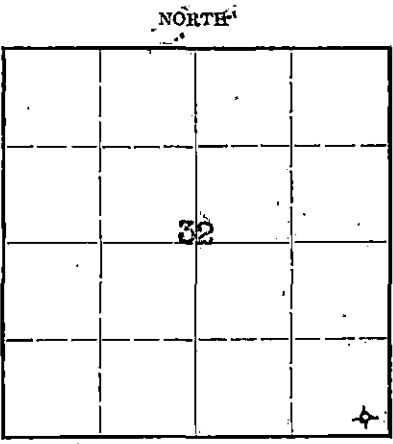

Locate well correctly on above
Section Plat.

If a producing well is abandoned, date of last production: 19...
Was permission obtained from the Conservation Division or its agents before plugging was com-
menced? YES

Name of Conservation Agent who supervised plugging of this well: Mr. W. H. Kerr, Great Bend, Kansas
Producing formation: Depth to top: Bottom: Total Depth of Well: 3826 Feet

Show depth and thickness of all water, oil and gas formations.

OIL, GAS OR WATER RECORDS

CASING RECORD

Formation	Content	From	To	Size	Put In	Pulled Out
				10-3/4	153	None

Describe in detail the manner in which the well was plugged, indicating where the mud fluid was placed and the method or methods used in introducing it into the hold. If cement or other plugs were used, state the character of same and depth placed, from...feet to...feet for each plug set.

Jetted pits - Circulated heavy mud 30 minutes - layed down 2000'
drill pipe - Filled hole with heavy mud - Layed down balance of drill
pipe - Filled hole with heavy mud to 150' - Placed wood plug at 150' -
run 20 sacks cement on this plug - Filled hole with heavy mud to 30' -
Placed another wood plug and poured 10 sacks cement on this plug.

32-12-20W
59-6

(If additional description is necessary, use BACK of this sheet)
Correspondence regarding this well should be addressed to: Donald T. Ingling
Address: 708 - 4th National Bank Bldg., Wichita 2, Kansas

STATE OF Kansas, COUNTY OF Sedgwick, ss.


(employee of owner) or (owner or operator) of the above-described well,
being first duly sworn on oath, says: That I have knowledge of the facts, statements, and matters herein contained and the log of the above-
described well as filed and that the same are true and correct. So help me God.

(Signature) [Signature]

708 - 4th Nat'l Bank Bldg., Wichita 2, Ks.
(Address)

SUBSCRIBED AND SWORN to before me this 13th day of

June 7, 1946
Leah V. Landrus
Notary Public.

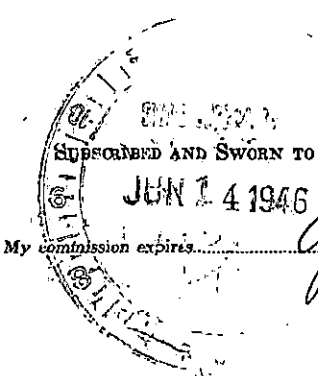

15.051.01148.00.00

WELL LOG SHUBERT NO. 1

Doley Oil Company - Lease Owners

Donald T. Ingling - Contractor

Total Depth: 3826'

Commenced: May 19, 1946
Completed: June 10, 1946

Casing: 153' of 10-3/4"

Sec. 32, Twp. 12, Range 20W

Location: SE SE SE

County: Ellis (Kansas)

Elevation:

Production:

Figures below indicate bottom of formation:

40	Surface Soil & Sand	2685	Lime & Shale
125	Post Rock & Shale	2735	Lime
515	Shale & Shells	2800	Lime & Shale
545	Sand	2945	Lime
590	Shale & Red Rock	3085	Lime & Shale
870	Shale & Sand (Streaks of Iron)	3130	Lime
1240	Sand	3220	Shale & Lime
1330	Shale & Red Bed	3665	Lime
1505	Shale & Shells	3705	Lime & Conglomerate
1553	Anhydrite	3752	Conglomerate
1565	Shale & Shells	3807	Conglomerate & Chert
1660	Py-Iron, Shale & Shells	3810	Conglomerate
2110	Shale & Shells	3812	Chert
2155	Shale & Lime	3826	Dolomite & Arbuckle
2220	Lime	3826	<u>TOTAL DEPTH</u>
2400	Lime & Shale		
2625	Lime		

I hereby certify that this is a true and correct log of the above-mentioned well.

FILE 32 12 20W
BOOK 59 6

DONALD T. INGLING

[Handwritten Signature]

STATE OF KANSAS

SS.

JUN 14 1946

SEDGWICK COUNTY

Subscribed and sworn to before me, a Notary Public in said County and State this 12th day of June, 1946.

[Handwritten Signature]

My Commission expires: 4/10/48