

STATE OF KANSAS
STATE CORPORATION COMMISSION

WELL PLUGGING RECORD


OR

FORMATION PLUGGING RECORD

Strike out upper line
when reporting plug-
ging off formations.

Give All Information Completely
Make Required Affidavit
Mail or Deliver Report to:
Conservation Division
State Corporation Commission
800 Bittling Building
Wichita, Kansas

NORTH

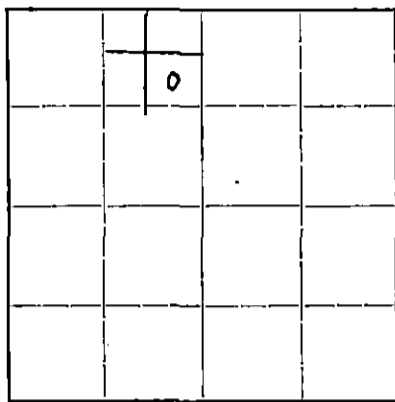

Locate well correctly on above
Section Plat

Stafford County, Sec. 31 Twp. 21 S. Rge. (E) 12(W)
Location as "NE 1/4 NW 1/4 SW 1/4" or footage from lines SE 1/4 NE 1/4 NW 1/4
Lease Owner G. W. Keyes Drilling Co., et al
Lease Name G. Fischer Well No. 1
Office Address Ellinwood, Kansas
Character of Well (completed as Oil, Gas or Dry Hole) Dry Hole
Date well completed May 3, 1946 19
Application for plugging filed May 19, 1946 19
Application for plugging approved May 19, 1946 19
Plugging commenced May 20, 1946 19
Plugging completed May 24, 1946 19
Reason for abandonment of well or producing formation Dry Hole

If a producing well is abandoned, date of last production - - - - 19
Was permission obtained from the Conservation Division or its agents before plugging was com-
menced? yes

Name of Conservation Agent who supervised plugging of this well H. W. Kerr
Producing formation - - - Depth to top - - Bottom - - Total Depth of Well 3651 Feet
Show depth and thickness of all water, oil and gas formations.


OIL, GAS OR WATER RECORDS

CASING RECORD

Formation	Content	From	To	Size	Put In	Pulled Out
Surface Pipe		0	260	8 5/8	260	0
Oil String		0	3632	5 1/2	3632	2854

Describe in detail the manner in which the well was plugged, indicating where the mud fluid was placed and the method or methods used in introducing it into the hole. If cement or other plugs were used, state the character of same and depth placed, from - - - feet to - - - feet for each plug set.

Filled bottom of hole with rock to 3400, cemented with 5 sacks at 3400; mudded back to 250, cemented with 10 sacks at 250; mudded hole to 15 feet, cemented with 10 sacks, cement returned to base of cellar.

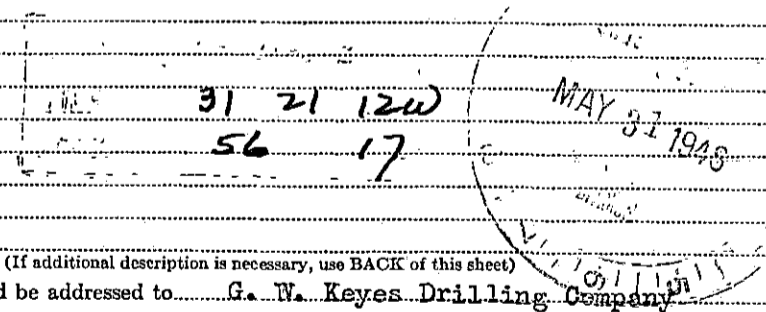

(If additional description is necessary, use BACK of this sheet)

Correspondence regarding this well should be addressed to G. W. Keyes Drilling Company
Address Ellinwood, Kansas

STATE OF Kansas, COUNTY OF Barton, ss.
I, G. W. Keyes, part owner (employee of owner) or (owner or operator) of the above-described well, being first duly sworn on oath, says: That I have knowledge of the facts, statements, and matters herein contained and the log of the above-described well as filed and that the same are true and correct. So help me God.

(Signature) G. W. Keyes
Ellinwood, Kansas (Address)

SUBSCRIBED AND SWORN to before me this 28th day of May, 1946.
J. J. Rader
Notary Public.

My commission expires July 7, 1948

WELL LOG

G. W. Keyes Drilling Co. et al, Owners - G. Fischer #1

SE NE NW Section thirty-one, Township twenty-one South, Range twelve West, Stafford County, Kansas.

Figures indicate bottom of formation

	0	to	155 sand	
Elevation:	1872			240 shale and sand
				662 red bed
				697 anhydrite
				1270 shale and shells
				1615 shale, shells and salt
Pipe:				1700 shale and broken lime
8 5/8" set at 260				1845 shale and shells
5 1/2" set at 3632				1960 broken lime
				2320 lime and shale
				2475 shale and shells
				2625 shale
Tops: Adjusted to derrick floor				2730 shale and shells
				2923 shale and lime
Heebner Shale	3150			3036 broken lime
Base Oread	3185			3228 lime
Brown Lime	3281			3319 shale, shells and lime
Lansing	3301			3550 lime
Viola Chert	3542			3585 chert
Simpson Shale	3582			3612 simpson shale
Arbuckle	3629			3632 shale
				3635 lime

1874
662

1212
1874
697

1167

Rotary started April 6, 1946
Completed April 15, 1946
3635 Total Rotary Depth, RBM

Moved in cable tools, drilled cement and cleaned out hole to original rotary depth and drilled deeper.

Cable Tools started April 23, 1946
Completed May 3, 1946 D&A
3640 lime
3642 broken lime
3644 soft lime
3645 hard lime
3648 lime
3651 sandy lime
3651 Total Depth, D&A

State of Kansas }
County of Barton } SS

I, G. W. Keyes, Part Owner of the above-described well, being first duly sworn on oath, declare: That I have knowledge of the facts, statements and matters herein contained pertaining to the log of the above-described well as filed and that the same are true and correct.

G. W. Keyes

Subscribed and Sworn to before me this 28th day of May 1946.

MAY 31 1946
J. J. Rader
Notary Public

PLUGGING
7, 1948. 31 21 12W
ECCOK 56 17

My commission expires July