

STATE OF KANSAS
STATE CORPORATION COMMISSION

WELL PLUGGING RECORD

Give Information Completely
Make Required Affidavit
Mail or Deliver Report to:
Conservation Division
State Corporation Commission
800 Bittling Building
Wichita, Kansas

OR

FORMATION PLUGGING RECORD

Strike out upper line
when reporting plug-
ging of formations.

Stafford County. Sec. 31 Twp. 21 Rge. 12 (E) (W)

Location as "NE $\frac{1}{4}$ NW $\frac{1}{4}$ SW $\frac{1}{4}$ " or footage from lines. NEc

Lease Owner Black-Marshall Oil Co.

Lease Name Sittner Well No. 1

Office Address Great Bend, Kansas.

Character of Well (completed as Oil, Gas or Dry Hole) dry-hole

Date well completed Mar. 15, 19 47

Application for plugging filed Mar. 19 19 47

Application for plugging approved Mar. 21 19 47

Plugging commenced May 10, 19 47

Plugging completed May 15, 19 47

Reason for abandonment of well or producing formation dry-hole

If a producing well is abandoned, date of last production 19

Was permission obtained from the Conservation Division or its agents before plugging was commenced? yes

H.W. Kerr

Name of Conservation Agent who supervised plugging of this well.

Producing formation Depth to top Bottom Total Depth of Well 3628 Feet

Show depth and thickness of all water, oil and gas formations.


OIL, GAS OR WATER RECORDS

CASING RECORD

Formation	Content	From	To	Size	Put In	Pulled Out
Rotary hole				8 5/8"	280'	none
					cemented w/125 sks Lone Star cement returned.	
				5 1/2" OD	3656'4"	2576'10"
				15.5#	cemented with 100 sks cement.	

Describe in detail the manner in which the well was plugged, indicating where the mud fluid was placed and the method or methods used in introducing it into the hold. If cement or other plugs were used, state the character of same and depth placed, from feet to feet for each plug set.

Dumped 5 sacks cement on bottom-filled hole with heavy mud to 200'-
set wood plug @ 200'-run 15 sacks cement-filled hole with heavy mud to 25'-
set wood plug @ 25'-run 10 sacks cement up into cellar.

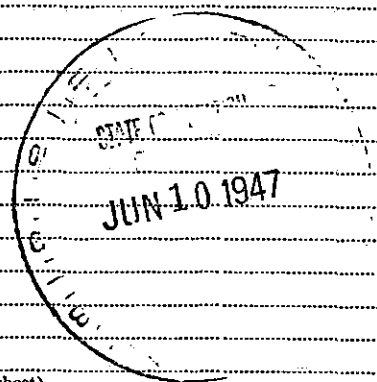

(If additional description is necessary, use BACK of this sheet)

Correspondence regarding this well should be addressed to Black-Marshall Oil Co
Address Great Bend, Kansas.

STATE OF Kansas, COUNTY OF Stafford, ss.

Walter C. Roberts. (employee of owner) or (owner or operator) of the above-described well, being first duly sworn on oath, says: That I have knowledge of the facts, statements, and matters herein contained and the log of the above-described well as filed and that the same are true and correct. So help me God.

(Signature) Walter C Roberts

Gaflin, Kansas.

(Address)

SUBSCRIBED AND SWORN to before me this 20 day of May, 19 47

Edwin Wydziaik
Notary Public.

My commission expires Feb. 5, 1951

PLUGGING
FILE SEC 31 T 21 R 12W
BOOK PAGE 102 LINE 43

JUN 5 1977

COMPANY: Black-Marshall Oil Company
 CONTRACTOR: Black-Marshall Oil Company

FARM: M. F. A. Sittner # 1
 LOCATION: NE NE NE 31-21-12W
 Stafford County, Kansas

COMMENCED: 3-1-47
 COMPLETED: 3-11-47

CASING RECORD:

8 5/8" @ 280' - 125 sks
 5 1/2" @ 3617' - 100 sks

ELEVATION: 1863'
 PRODUCTION: D & A

Formation:Depth

Sand	230
Shale	280
Red bed and shale	425
Red bed, shale and sand	905
Shale and shells	1240
Shale and salt	1560
Shale and lime	1690
Shale and shells	1925
Shale and lime	2485
Shale	2660
Shale and lime	3080
Lime	3245
Lime, shells and shale	3300
Lime	3410
Shale and lime	3545
Chert	3565
Chert and shale	3595
Lime	3618

TOPS

Lansing	3277
Base Kansas City	3510
Viola	3524
Simpson	3566
Artuckle	3616

ROTARY TOTAL DEPTH 3618

STATE OF KANSAS)
) SS
 COUNTY OF BARTON)

We hereby certify this to be a correct and accurate log of the above described well as shown by the daily drilling reports.

BLACK-MARSHALL OIL COMPANY

[Signature]
 Vice-President

Subscribed and sworn to before me this 19th day of March, 1947.

[Signature]
 Notary Public

My commission expires February 19, 1949.

PLUGGING
 FILE SEC 31 T 2 LR 12W
 BOOK PAGE 102 LINE 43

15.185.11456.0000

COMPANY: Black-Marshall Oil Company FARM: M. F. A. Sittner # 1
 CONTRACTOR: Black-Marshall Oil Company LOCATION: NE NE NE S1-21-12W
 Stafford, County, Kansas
 COMMENCED: 3-1-47
 COMPLETED: 3-11-47 CASING RECORD:
 8 5/8" @ 280' - 125 sks
 5 1/2" @ 3617' - 100 sks
 ELEVATION: 1863'
 PRODUCTION: D & A

Formation:

Depth

Sand	230	
Shale	280	
Red bed and shale	425	
Red bed, shale and sand	905	
Shale and shells	1240	
Shale and salt	1560	
Shale and lime	1690	
Shale and shells	1925	
Shale and lime	2485	
Shale	2660	
Shale and lime	3080	
Lime	3245	Lansing 3277
Lime, shells and shale	3300	Base Kansas City 3510
Lime	3410	Viola 3524
Shale and lime	3545	Simpson 3566
Chet	3565	Arbuckle 3616
Chet and shale	3595	
Lime	3618	
ROTARY TOTAL DEPTH	3618	

