


WELL PLUGGING RECORD

Give All Information Completely  
Make Required Affidavit  
Mail or Deliver Report to:  
Conservation Division  
State Corporation Commission  
211 No. Broadway  
Wichita, Kansas

Stafford County, Sec. 31 Twp. 21 Rge. (E) 12 (W)  
Location as "NE/CNW/SW" or footage from lines SW - NE - SW  
Lease Owner Frank J. Black  
Lease Name Fisher Well No. 1  
Office Address McPherson, Kansas  
Character of Well (completed as Oil, Gas or Dry Hole) Oil Well  
Date well completed 6-21 19 51  
Application for plugging filed 10-22 19 57  
Application for plugging approved 10-23 19 57  
Plugging commenced 10-23 19 57  
Plugging completed 11-8 19 57  
Reason for abandonment of well or producing formation Unprofitable

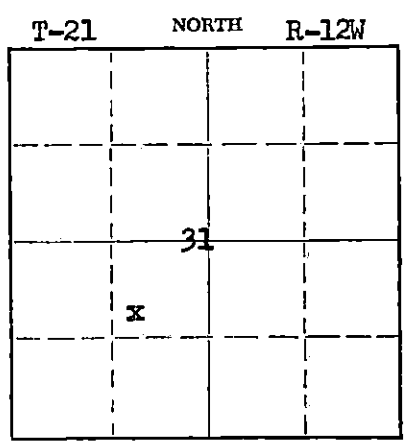

Locate well correctly on above  
Section Plat

If a producing well is abandoned, date of last production Unknown 19  
Was permission obtained from the Conservation Division or its agents before plugging was commenced? Yes

Name of Conservation Agent who supervised plugging of this well Donald Truan  
Producing formation \_\_\_\_\_ Depth to top \_\_\_\_\_ Bottom \_\_\_\_\_ Total Depth of Well 3632 Feet  
Show depth and thickness of all water, oil and gas formations.

OIL, GAS OR WATER RECORDS CASING RECORD

FORMATION	CONTENT	FROM	TO	SIZE	PUT IN	PULLED OUT
				8 5/8	244	None
				5 1/2	3631	2379.48

Describe in detail the manner in which the well was plugged, indicating where the mud fluid was placed and the method or methods used in introducing it into the hole. If cement or other plugs were used, state the character of same and depth placed, from \_\_\_\_\_ feet to \_\_\_\_\_ feet for each plug set.

Sanded to 3620' - dumped 5 sks cement - pulled pipe -  
Mudded hole to 250' - set rock bridge - dumped 25 sks cement - mudded  
to 40' - set rock bridge - dumped 10 sks cement.

RECEIVED  
STATE CORPORATION COMMISSION

NOV 16 1957

CONSERVATION DIVISION  
Wichita, Kansas

(If additional description is necessary, use BACK of this sheet)  
Name of Plugging Contractor R & D Casing Pulling Company License # 236  
Address Box 569 Ellinwood, Kansas

STATE OF McPherson COUNTY OF Kansas, ss.  
(employee of owner) or (owner or operator) of the above-described well, being first duly sworn on oath, says: That I have knowledge of the facts, statements, and matters herein contained and the log of the above-described well as filed and that the same are true and correct. So help me God.

(Signature) *[Handwritten Signature]*

SUBSCRIBED AND SWORN TO before me this 15 day of Nov, 19 57

My commission expires Jan 10 - 1961  
Notary Public. *[Handwritten Signature]*

PLUGGING  
FILE SEC 31 T 21 R 12W  
BOOK PAGE 54 LINES

COPY


WELL LOG BUREAU - KANSAS GEOLOGICAL SOCIETY  
503 East Murdock, Wichita, Kansas

Company- DIZDAR INVESTMENT CO.  
Farm- Fischer No. 1

SEC. 31 T. 21 R. 12W  
SW NE SW

Total Depth. 3632  
Comm. 6-10-51 Date 6-21-51  
Shot or Treated.  
Contractor. Glenn R. Nye  
Issued. 12-20-52

County Stafford  
KANSAS

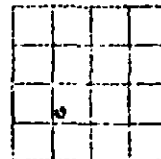

Elevation. 1870

Production. Pump 300 bbls oil

CASING:

8 5/8" 244'  
5 1/2" 3631'


sand	230
shale, shells	244
red rock, sand	757
shale	800
anhydrite	905
shale	1220
shale, sand	1619
lime, shale	1810
lime, shale, sand	2010
lime, shale	2415
shale, shells	2545
shale, lime	2700
shale, lime shells	2785
shale, lime	3000
sand	3010
sand, shale	3110
lime, shale	3350
lime	3370
lime, shale	3632
Total Depth	

Tops:  
Arbuckle 3029  
Lansing 3316

RECEIVED  
STATE CORPORATIONS COMMISSION

NOV 16 1957

CONSERVATION DIVISION  
Wichita, Kansas

PLUGGING  
FILE SEC 31 T 21 R 12W  
BOOK PAGE 56 LINE 5