


STATE OF KANSAS  
STATE CORPORATION COMMISSION

WELL PLUGGING RECORD

Give All Information Completely  
Make Required Affidavit  
Mail or Deliver Report to:  
Conservation Division  
State Corporation Commission  
800 Bitting Building  
Wichita, Kansas

Stafford County. Sec. 30 Twp. 21 Rge. 12 (E) W (W)

Location as "NE/CNW/SW" or footage from lines C N/2 NE/4 NE/4  
Lease Owner Republic Natural Gas Company  
Lease Name Fischer "B" Well No. 3  
Office Address Box 126, Ellinwood, Kansas  
Character of Well (completed as Oil, Gas or Dry Hole) Oil  
Date well completed January 25 1946  
Application for plugging filed June 4 1954  
Application for plugging approved June 5 1954  
Plugging commenced June 8 1954  
Plugging completed June 15 1954  
Reason for abandonment of well or producing formation Depleted

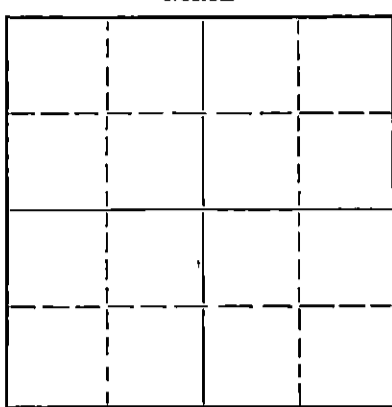

Locate well correctly on above  
Section Plat

If a producing well is abandoned, date of last production April 14 1954  
Was permission obtained from the Conservation Division or its agents before plugging was commenced? Yes

Name of Conservation Agent who supervised plugging of this well M. A. Rives  
Producing formation Arbuckle Depth to top 3592' Bottom Total Depth of Well 3637' Feet  
Show depth and thickness of all water, oil and gas formations.

OIL, GAS OR WATER RECORDS

CASING RECORD

Formation	Content	From	To	Size	Put In	Pulled Out
				8-5/8"	304'	None
				5-1/2"	3597' 6"	3115'
Arbuckle	Oil	3592	3608			
Lansing	Water	Perf. 3474	3478			
"	"	" 3431	3436			
"	"	" 3413	3418			
"	"	" 3393	3400			
"	"	" 3336	3340			

Describe in detail the manner in which the well was plugged, indicating where the mud fluid was placed and the method or methods used in introducing it into the hole. If cement or other plugs were used, state the character of same and depth placed, from.....feet to.....feet for each plug set.

- 3337 Halliburton plug and cement
- 3337 to 3325 Sand bridge
- 3325 to 3295 5 sacks cement
- 3295 to 300 Mudded
- 300 to 275 Rock bridge
- 275 to 215 20 sacks cement
- 215 to 30 Mud
- 30 to cellar 10 sacks cement

(If additional description is necessary, use BACK of this sheet)

Name of Plugging Contractor R. & S. Pipe Pulling Company  
Address Box 917, Ellinwood, Kansas

STATE OF Kansas, COUNTY OF Barton, ss.  
P. B. Horst (employee of owner) or (owner or operator) of the above-described well,

being first duly sworn on oath, says: That I have knowledge of the facts, statements, and matters herein contained and the log of the above-described well as filed and that the same are true and correct. So help me God.

(Signature) P.B. Horst

Box 126, Ellinwood, Kansas (Address)

SUBSCRIBED AND SWORN to before me this 18th day of June, 1954.

My commission expires 8-20-55

Notary Public. [Signature]

23-8390 8-51-20M

**PLUGGING**

FILE SEC 30 T 21 R 12W

BOOK PAGE 39 LINE 11

6-21-54  
CONSERVATION DIVISION  
WICHITA, KANSAS


WELL LOG BUREAU—KANSAS GEOLOGICAL SOCIETY  
503 East Murdock, Wichita, Kansas

Company- GABBERT-JONES DRILLING  
Farm- Fischer "B" No. 27

SEC. 30 T. 21 R. 12W  
SW NE NE

Total Depth. 3460'  
Comm. 9-17-54 Comp. 9-29-54  
Shot or Treated.  
Contractor.  
Issued. 12-4-54

County Stafford  
KANSAS

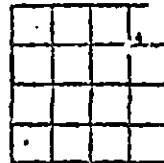

CASING:  
8 5/8" 293' w/225 sx cem.  
5 1/2" 3639' w/100 sx cem.

Elevation. 1867'

Production. 85 BO/32% wtr.

Figures indicate Bottom of Formations.

sand-shale	235
red bed	295
red bed	680
anhydrite	700
red bed-shale	985
shale	1490
shale-lime	1550
lime	1740
shale-lime	1950
shale-s shells	2105
lime	2190
shale-shells	2270
s hale	2612
shale-shells	2740
shale-lime	2930
lime	3525
lime-shale	3590
lime	3640
Total Depth	

TOPS: Scout	
Lansing	3271
Viola	3498
Simpson	3527
Arbuckle	3582

RECEIVED  
STATE CORPORATION COMMISSION  
JAN 6 1970  
CONSERVATION DIVISION  
Wichita, Kansas

DEC 13 1969