

STATE OF KANSAS  
STATE CORPORATION COMMISSION


WELL PLUGGING RECORD

Give All Information Completely  
Make Required Affidavit  
Mail or Deliver Report to:  
Conservation Division  
State Corporation Commission  
800 Bittling Building,  
Wichita, Kansas

OR  
FORMATION PLUGGING RECORD

Strike out upper line  
when reporting plug-  
ging of formations.

Stafford County. Sec. 30 Twp. 21 Rge. (E) 12 (W)  
Location as "NE 1/4 NW 1/4 SW 1/4" or footage from lines. NE c S/2 SE/4  
Lease Owner. M. B. Armer  
Lease Name. Fischer Well No. 1  
Office Address. 306 Insurance Bldg., Wichita, Kansas  
Character of Well (completed as Oil, Gas or Dry Hole). oil well  
Date well completed. May 19 47  
Application for plugging filed. July 6 19 49  
Application for plugging approved. July 6 19 49  
Plugging commenced. July 9 19 49  
Plugging completed. July 17 19 49  
Reason for abandonment of well or producing formation. Production depleted

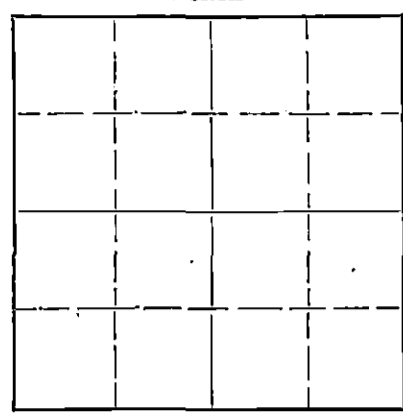

Locate well correctly on above  
Section Plat

Name of Conservation Agent who supervised plugging of this well. C. D. Stough  
Producing formation. Arbuckle Depth to top. 3609 Bottom. 3621 Total Depth of Well. 3621 Feet  
Show depth and thickness of all water, oil and gas formations.

OIL, GAS OR WATER RECORDS

CASING RECORD

Formation	Content	From	To	Size	Put In	Pulled Out
				8-5/8	278'	none
Lansing KC	none					
Arbuckle	oil & water	3609	3621	5 1/2"	3606'	1823'

Describe in detail the manner in which the well was plugged, indicating where the mud fluid was placed and the method or methods used in introducing it into the hole. If cement or other plugs were used, state the character of same and depth placed, from \_\_\_\_\_ feet to \_\_\_\_\_ feet for each plug set.

Mudded to 3600 ft. bridged & ran 5 sax cement  
Mudded to 250 ft. bridged & ran 15 sax cement  
Mudded to 25 ft. bridged & ran 10 sax cement.

RECEIVED  
Conservation Div.  
JUL 27 1949  
STATE CORPORATION  
COMMISSION  
KANSAS

(If additional description is necessary, use BACK of this sheet)

Correspondence regarding this well should be addressed to. M. B. Armer  
Address. 306 Insurance Bldg., Wichita 2, Kansas

STATE OF Kansas, COUNTY OF Sedgwick, ss.  
M. B. Armer

(Employment owner) or (owner or operator) of the above-described well,  
being first duly sworn on oath, says: That I have knowledge of the facts, statements, and matters herein contained and the log of the above-described well as filed and that the same are true and correct. So help me God.

(Signature) M. B. Armer

306 Insurance Bldg., Wichita 2, Kansas (Address)

SUBSCRIBED AND SWORN to before me this 26th day of July, 19 49

Walter Walton  
Notary Public.

My commission expires. Sept. 17, 1951

PLUGGING  
FILE SEC 30T 21N 12W  
BOOK PAGE 106 QUITE 11

Company: M. B. Armer  
Contractor: M. B. Armer  
Commenced: 5/8/47  
Completed: 5/22/47  
Elevation: 1866  
Drilled with Rotary Tools

Farm: Fischer #1  
Location: N E C S<sup>1</sup>/<sub>2</sub> SE<sup>1</sup>/<sub>2</sub>  
Section 30-21-12W,  
Stafford County, Kansas  
Casing Record: 3606' - 5<sup>1</sup>/<sub>2</sub>" \* 50 Sx Cement  
278' - 8 5/8" - 175 Sx  
Cement

Figures Below indicate Bottoms

Clay and Sand	220
Shale & Shells	258
Red-Bed, Shale & Shells	380
Shale & Shells	524
Red Bed - Shale & Shells	800
Shale & Shells	1095
Shale, Shells & Salt	1275
Shale & Shells	1530
Lime & Shale	1620
Shale & Shells	1710
Lime	1720
Lime & Shale	2185
Shale & Shells	2670
Shale & Lime	3035
Lime	3130
Lime & Shale	3290
Lime	3330
Lime & Shale	3485
Lime	3532
Lime	3563
Shale	3593
Lime	3609 - T.D. Rotary
Green Shale	3612
Lime	3621

Tops of Lansing K.C.	3272
Top of Simpson	3549
Top of Arbuckle	3609
	<u>1866</u>
	- 1743

I hereby certify that this is a true and correct log of the above described well as shown by the drilling reports.

M. B. Armer  
M. B. Armer

STATE OF KANSAS )  
COUNTY OF SEDGWICK ) SS

Subscribed and sworn to before me, a Notary Public in and for said County and State, this 17 day of July, 1947.

Margaret M. Dial  
Notary Public

My Commission expires: NOTARY PUBLIC  
My Commission Expires April 9, 1951

**PLUGGING**  
WEL SEC 30 7 27 1/2 18W  
BOOK PAGE 106 LINE 11

**RECEIVED**  
Conservation Div.  
JUL 27 1949  
STATE CORPORATION  
COMMISSION  
KANSAS