


WELL PLUGGING RECORD

Give All Information Completely
Make Required Affidavit
Mail or Deliver Report to:
Conservation Division
State Corporation Commission
800 Bitting Building
Wichita, Kansas

Stafford County, Sec. 30 Twp. 21S. Rge. 12 (E) W (W)
Location as "NE/CNW $\frac{1}{4}$ /SW $\frac{1}{4}$ " or footage from lines NW SW SE
Lease Owner Alpine Oil & Royalty Co., Inc.
Lease Name Fischer Well No. 1
Office Address 300 Bitting Building, Wichita 2, Kansas
Character of Well (completed as Oil, Gas or Dry Hole) Dry Hole
Date well completed February 1 19 51
Application for plugging filed February 1 19 51
Application for plugging approved February 1 19 51
Plugging commenced February 1 19 51
Plugging completed February 1 19 51
Reason for abandonment of well or producing formation Dry Hole

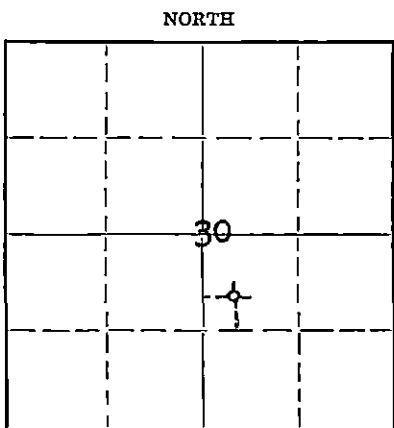

Locate well correctly on above
Section Plat

If a producing well is abandoned, date of last production 19...
Was permission obtained from the Conservation Division or its agents before plugging was commenced? Yes

Name of Conservation Agent who supervised plugging of this well C. D. Stough
Producing formation Depth to top Bottom Total Depth of Well Feet
Show depth and thickness of all water, oil and gas formations.

OIL, GAS OR WATER RECORDS

CASING RECORD

Formation	Content	From	To	Size	Put In	Pulled Out
				8 5/8"	332'	Cemented

Describe in detail the manner in which the well was plugged, indicating where the mud fluid was placed and the method or methods used in introducing it into the hole. If cement or other plugs were used, state the character of same and depth placed, from feet to feet for each plug set.

Solid plug at 300', and 15 sacks mud to 35'. Solid plug and ten sacks cement.

RECEIVED
STATE CORPORATION COMMISSION
FEB 6 1951
CONSERVATION DIVISION
Wichita, Kansas

(If additional description is necessary, use BACK of this sheet)

Correspondence regarding this well should be addressed to Alpine Oil & Royalty Co., Inc.
Address 300 Bitting Building, Wichita 2, Kansas

STATE OF Kansas, COUNTY OF Sedgwick, ss.
Thomas M. McCaul (employee of owner) or (owner or operator) of the above-described well, being first duly sworn on oath, says: That I have knowledge of the facts, statements, and matters herein contained and the log of the above-described well as filed and that the same are true and correct. So help me God.
(Signature) Thomas M. McCaul
President
300 Bitting Building, Wichita, Kansas
(Address)

SUBSCRIBED AND SWORN TO before me this 5th day of February, 1951.

Notary Public

My commission expires August 8, 1953.

PLUGGING
FILE SEC 30 T 21 R 12W
BOOK PAGE 59 LINE 40

WELL LOG

Alpine Oil & Royalty Co., Inc. et al

Commenced: 1-20-51

Contractor: Quaker Drilling Co., Inc.

Completed: 2-1-51

Margaretha Fischer No. 1
NW SW SE Sec. 30-21S-12W
Stafford County, Kansas

Production: D & A

Elevation: 1868 R.B.

Casing Record:

Set 332' of 8 5/8" with 230 sacks cement.

(Figures Indicate Bottom of Formations)

<u>FORMATION</u>	<u>DEPTH</u>	<u>FORMATION TOPS</u>	
Surface Clay and Sand	75	Heebner	3165 -1297
Sand	260	Brown Lime	3296 -1428
Shale and Red Bed	355	Lansing	3312 -1444
Red Bed and Blue Shale	690	Pennsylvanian Cong.	3559 -1691
Anhydrite	725	Viola Conglomerate	3574 -1706
Shale and Shells	800	Simpson	3618 -1750
Shale and Lime	1585	T.D. Rotary	3693 -1825
Lime	1685		
Lime and Shale	1975		
Lime	2085		
Lime and Shale	2705		
Lime	3005		
Lime and Shale	3100		
Lime	3190		
Lime and Shale	3457		
Lime	3592		
Cherty Lime and Shale	3693 TD		

1868
640
1178

I hereby certify that the above is a true and correct copy of Driller's Log of well drilled in the NW SW SE of Section 30, Township 21 South, Range 12 West, Stafford County, Kansas.

ALPINE OIL & ROYALTY CO., INC.

By: *Edward M. Paul*

Subscribed and sworn to before me this 5th day of February, 1951.

Edward Allen
Notary Public

My commission expires:
August 8, 1953.

RECEIVED
STATE CORPORATION COMMISSION
FEB 6 1951
CONSERVATION DIVISION
Wichita, Kansas

PLUGGING
FILE SEC. 30-21S-12W
BOOK PAGE 59 LINE 40