


STATE OF KANSAS  
STATE CORPORATION COMMISSION

WELL PLUGGING RECORD

Give All Information Completely  
Make Required Affidavit  
Mail or Deliver Report to:  
Conservation Division  
State Corporation Commission  
800 Bittling Building  
Wichita, Kansas

Stafford County, Sec. 30 Twp. 21 Rge. (E) 12 (W)

Location as "NE/CNW $\frac{1}{4}$ /SW $\frac{1}{4}$ " or footage from lines NE $\frac{1}{4}$  NW $\frac{1}{2}$  SW $\frac{1}{2}$   
Lease Owner Isern Drilling Company et al  
Lease Name Hugo Well No. 1  
Office Address Box 92, Ellinwood, Kansas  
Character of Well (completed as Oil, Gas or Dry Hole) Dry Hole  
Date well completed 9-8-51 19  
Application for plugging filed 9-8-51 19  
Application for plugging approved 9-8-51 19  
Plugging commenced 9-8-51 19  
Plugging completed 9-8-51 19  
Reason for abandonment of well or producing formation Dry hole

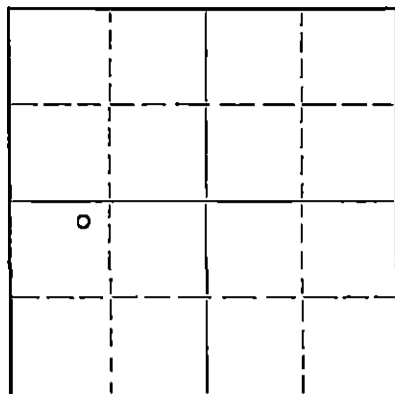

Locate well correctly on above Section Plat

If a producing well is abandoned, date of last production 19  
Was permission obtained from the Conservation Division or its agents before plugging was commenced? Yes

Name of Conservation Agent who supervised plugging of this well C. D. Stough  
Producing formation Depth to top Bottom Total Depth of Well 3710 Feet  
Show depth and thickness of all water, oil and gas formations.

OIL, GAS OR WATER RECORDS

CASING RECORD

Formation	Content	From	To	Size	Put In	Pulled Out
Surface Pipe		0	283'	8-5/8"	283'	None

Describe in detail the manner in which the well was plugged, indicating where the mud fluid was placed and the method or methods used in introducing it into the hole. If cement or other plugs were used, state the character of same and depth placed, from feet to feet for each plug set.

Mudded hole with heavy mud to 280'. Bridged and plugged with 15 sacks cement.  
Mudded hole with heavy mud to 35'. Bridged and cemented with 10 sacks, cement returning to base of cellar.

RECEIVED  
STATE CORPORATION COMMISSION  
SEP 13 1951  
CONSERVATION DIVISION  
Wichita, Kansas

(If additional description is necessary, use BACK of this sheet)  
Correspondence regarding this well should be addressed to G. W. Keyes Drilling Co.  
Address Box 92  
Ellinwood, Kansas

STATE OF KANSAS, COUNTY OF BARTON, ss.  
I, Edw. H. Isern, Part Owner (employer of owner) or (owner or operator) of the above-described well, being first duly sworn on oath, says: That I have knowledge of the facts, statements and matters herein contained and the log of the above-described well as filed and that the same are true and correct. So help me God.

(Signature) Edw. H. Isern  
Ellinwood, Kansas (Address)

SUBSCRIBED AND SWORN to before me this 12th day of September, 1951

My commission expires Feb. 10, 1955  
George Meyer Notary Public

PLUGGING  
FILE SEC 20 T 21 R 12  
LOOK PAGE 128 15133

WELL LOG

15.195.02017.0000

Isern Drilling Company et al, Owner - Hugo #1  
NE 1/4 NW 1/4 SW 1/4 Section 30, Township 21, Range 12 W.  
Stafford County, Kansas

Elevation: 1869' DF

Figures indicate bottom of formation

Pipe Record:

8-5/8" set @ 283'

Tops corrected 2' to derrick floor

Heebner	3170'
Brown Lime	3302'
Lansing	3319'
Conglomerate	3570'
Viola	3617'
Simpson	3635'
Arbuckle	3691'

0	to	30	surface clay
		130	sand and shale
		230	sand
		695	red bed
		725	anhydrite
		1200	shale and shells
		1430	salt
		1550	shale and shells
		1648	lime and shale
		1705	shale and shells
		1730	lime and shale
		1745	sand
		2000	lime and shale
		2560	shale and shells
		2840	lime and shale
		2880	shale and lime
		3465	lime and shale
		3580	lime
		3610	conglomerate
		3666	lime
		3691	simpson shale
		3740	arbuckle
		3740	Total Depth D & A

Rotary commenced	8-29-51
" completed	9- 8-51

1874  
695  
4176

STATE OF KANSAS )  
COUNTY OF BARTON ) SS

I, Edw. H. Isern, Part Owner of the above-described well, being first duly sworn on oath, declare: That I have knowledge of the facts, statements and matters herein contained pertaining to the log of the above-described well as filed, and that the same are true and correct.

*Edw. H. Isern*

Subscribed and Sworn to before me this 12th day of September, 1951.

*George A Meyer*  
Notary Public

My commission expires Feb. 10, 1955.

RECORDED  
INDEXED  
SEP 13 1951  
COUNTY OF BARTON  
KANSAS

FILED  
30-21-1200  
108-33