


STATE OF KANSAS
STATE CORPORATION COMMISSION

WELL PLUGGING RECORD

Give All Information Completely
Make Required Affidavit
Mail or Deliver Report to:
Conservation Division
State Corporation Commission
800 Bitting Building
Wichita, Kansas

Stafford County. Sec. 26 Twp. 21 Rge. 13 (W)
Location as "NE/CNW $\frac{1}{4}$ /SW $\frac{1}{4}$ " or footage from lines SW SW NE
Lease Owner Nadel and Gussman
Lease Name Fanshier "A" "A" Well No. 1
Office Address 703 Union National Bank Bldg. Wichita, Kansas
Character of Well (completed as Oil, Gas or Dry Hole) Dry Hole
Date well completed June 12 1950
Application for plugging filed June 12 1950
Application for plugging approved June 12 1950
Plugging commenced June 12 1950
Plugging completed June 12 1950
Reason for abandonment of well or producing formation Dry Hole

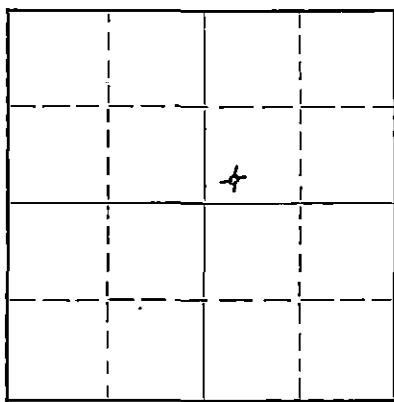

If a producing well is abandoned, date of last production 19
Was permission obtained from the Conservation Division or its agents before plugging was commenced? Yes

Name of Conservation Agent who supervised plugging of this well C. D. Stough
Producing formation Depth to top Bottom Total Depth of Well 3740 Feet
Show depth and thickness of all water, oil and gas formations.

OIL, GAS OR WATER RECORDS

CASING RECORD

Formation	Content	From	To	Size	Put In	Pulled Out
		0	322'	8 5/8"	322'	None

Describe in detail the manner in which the well was plugged, indicating where the mud fluid was placed and the method or methods used in introducing it into the hole. If cement or other plugs were used, state the character of same and depth placed, from feet to feet for each plug set.

3740' to 321 $\frac{1}{2}$ ' - Heavy Rotary Mud
321 $\frac{1}{2}$ ' to 320' - Wooden Plug
320' to 274' - 15 sacks cement
274' to 35 $\frac{1}{2}$ ' - Heavy Rotary Mud
35 $\frac{1}{2}$ ' to 35' - Wooden Plug
35' to 6' - 10 sacks cement
6' to Surface - Celler

(If additional description is necessary, use BACK of this sheet)

Correspondence regarding this well should be addressed to Nadel and Gussman
Address 703 Union National Bank Building Wichita, Kansas

STATE OF Kansas, COUNTY OF Barton, ss.
Glenn Peel Drilling Company, Inc. (employee of owner) or (owner) of the above-described well,
being first duly sworn on oath, says: That I have knowledge of the facts, statements, and matters herein contained and the log of the above-described well as filed and that the same are true and correct. So help me God. GLENN PEEL DRILLING COMPANY, INC.

BY: [Signature] P. O. Box 359 Hoisington, Kansas

SUBSCRIBED AND SWORN to before me this 14th day of June 1950
[Signature] Notary Public.

My commission expires June 4, 1951 22-7877-8 4-49-10M

JUN 19 1950

PLUGGING
FILE SEC. 26 T. 21 R. 13
BOOK PAGE 11 LINE 5

DRILLER'S LOG

Company: Nadel and Gussman
 Farm Name: Fanshier "B" Well No. 1
 Total Depth: 3740' (Rotary)
 Comm: 6-4-50 Comp: 6-12-50
 Contractor: Glenn Peel Drilling Company, Inc.
 Casing: 8 5/8" 322' csm.

Sec. 26, Twp. 21, Rge. 13W,
 SW SW NE
 County: Stafford,
 Kansas
 Elevation:
 Production: Dry

Figures below indicate bottom of formations

Surface Clay & Sand	0 -	100
Sand		200
Shale		324
Shale & Shells		715
Anhydrite		745
Shale & Shells		1000
Shale		1580
Lime & Shale		1750
Lime		1915
Lime w/shale breaks		2095
Lime & Shale		2505
Shale & Lime		2680
Lime & Shale		3060
Lime		3140
Lime & Shale		3300
Lime w/broken shale		3334
Lime		3580
Conglomerate		3740
Total Depth		3740


This is to certify that the above information is, to the best of our knowledge, true and correct.

GLENN PEEL DRILLING COMPANY, INC.

BY: *P. O. Sutton*

SUBSCRIBED AND SWORN to before me this 14th day of June, 1950

My commission expires June 4, 1951 *Marion M. Herbst*
Notary Public

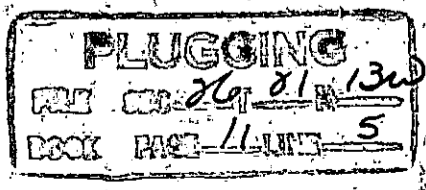

JUN 19 1950