


WELL PLUGGING RECORD

Give All Information Completely
Make Required Affidavit
Mail or Deliver Report to:
Conservation Division
State Corporation Commission
800 Bittling Building
Wichita, Kansas

Stafford County, Sec. 26 Twp 21S Rge 13 (E) W (W)
C/E2 E/2 NE/4

Location as "NE/CNW/SW" or footage from lines
Lease Owner Peel-Hardman
Lease Name Fanshier "B"
Office Address P. O. Box 359 Hoisington, Kansas Well No. 1
Character of Well (completed as Oil, Gas or Dry Hole) Dry Hole
Date well completed October 23 19 50
Application for plugging filed October 23 19 50
Application for plugging approved October 23 19 50
Plugging commenced October 23 19 50
Plugging completed October 23 19 50
Reason for abandonment of well or producing formation Dry Hole

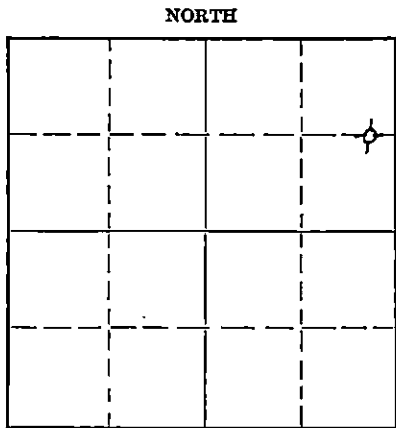

Locate well correctly on above
Section Plat

If a producing well is abandoned, date of last production 19
Was permission obtained from the Conservation Division or its agents before plugging was commenced? Yes

Name of Conservation Agent who supervised plugging of this well Harold Hollis Great Bend, Kansas
Producing formation Depth to top Bottom Total Depth of Well Feet

Show depth and thickness of all water, oil and gas formations.

OIL, GAS OR WATER RECORDS

CASING RECORD

Formation	Content	From	To	Size	Put In	Pulled Out
		0	337'	8 5/8"	337'	None

Describe in detail the manner in which the well was plugged, indicating where the mud fluid was placed and the method or methods used in introducing it into the hole. If cement or other plugs were used, state the character of same and depth placed, from feet to feet for each plug set.

3697' - 321 1/2' - Heavy Rotary Mud
321 1/2' - 320' - Wooden Plug
320' - 273' - 15 sacks cement
273' - 36 1/2' - Heavy Rotary Mud
36 1/2' - 35' - Wooden Plug
35' - 6' - 10 sacks cement
6' - Cellar - Surface

STATE CORPORATION COMMISSION
OCT 28 1950
CONSERVATION DIVISION
Wichita, Kansas

(If additional description is necessary, use BACK of this sheet)

Correspondence regarding this well should be addressed to Peel-Hardman
Address Post Office Box 359 Hoisington, Kansas

STATE OF Kansas, COUNTY OF Barton, ss.
Glenn Peel Drilling Co., Inc. (employee of owner) or (owner or operator) of the above-described well,
being first duly sworn on oath, says: That I have knowledge of the facts, statements, and matters herein contained and the log of the above-described well as filed and that the same are true and correct. So help me God. Glenn Peel Drilling Company, Inc.

(Signature) BY: *Glenn Peel*
P. O. Box 359 Hoisington, Kansas (Address)

SUBSCRIBED AND SWORN to before me this 27th day of October, 1950

My commission expires June 4, 1951
Marion M. Hakes Notary Public.

28-3278-s-450-10M
PLUGGING
FILE SEC 26 T 21 R 13 W
BOOK PAGE 38 LINE 32

DRILLER'S LOG

Company: Peel-Hardman
 Farm: Fanshier "B" Well No. 1
 Total Depth: 3697'
 Comm: 10-14-50 Comp: 10-23-50
 Contractor: Glenn Peel Drilling Co., Inc.
 Casing: 8 5/8" 337' cem.

Sec. 26, Twp. 21S, Rge. 13W,
 C/E2 E/2 NE/4
 County: Stafford,
 Kansas
 Elevation:
 Production: Dry

Figures below indicate bottom of formations

Sand Clay & Shale	0 -	220
Shale & Shells		300
Shale		338
Shale & Red Bed		720
Anhydrite		755
Shale & Shells		1275
Salt & Shale		1450
Shale & Shells		1732
Lime		1778
Broken Lime & Shale		1965
Lime		2180
Shale & Lime		2510
Lime & Shale		2527
Shale		2652
Lime & Shale		2695
Shale & Lime		2990
Lime & Shale		3331
Lime		3598
Shale		3638
Lime		3697
Total Depth		3697

This is to certify that the above information is, to the best of our knowledge, true and correct.

GLENN PEEL DRILLING COMPANY, INC.

BY: *Glenn Peel*

SUBSCRIBED AND SWORN to before me this 27th day of October, 1950.

My commission expires June 4, 1951

Marian M. Herbert
Notary Public

