


STATE OF KANSAS
STATE CORPORATION COMMISSION

Form CP-4

Give All Information Completely
Make Required Affidavit
Mail or Deliver Report to:
Conservation Division
State Corporation Commission
211 No. Broadway
Wichita, Kansas

WELL PLUGGING RECORD

NORTH

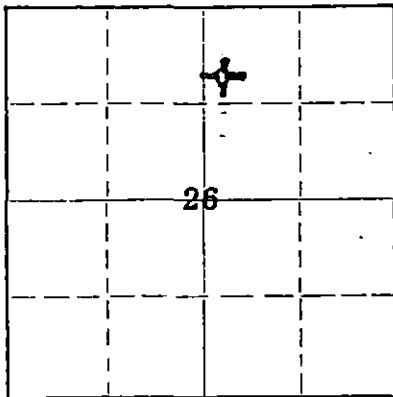

Locate well correctly on above
Section Plat

Stafford County. Sec. 26 Twp. 21S Rge. 13W (KK (W)
Location as "NE/CNWxSWx" or footage from lines SW NW NE
Lease Owner Aylward Drilling Co.
Lease Name Kanshier Well No. 1
Office Address 909 First Natl. Bank Bldg., Wichita, Kansas
Character of Well (completed as Oil, Gas or Dry Hole) Dry Hole
Date well completed August 8, 19 66
Application for plugging filed August 8, 19 66
Application for plugging approved August 8, 19 66
Plugging commenced August 8, 19 66
Plugging completed August 8, 19 66
Reason for abandonment of well or producing formation Dry Hole

If a producing well is abandoned, date of last production _____ 19____
Was permission obtained from the Conservation Division or its agents before plugging was commenced? Yes

Name of Conservation Agent who supervised plugging of this well _____
Producing formation _____ Depth to top _____ Bottom _____ Total Depth of Well 3740 Feet
Show depth and thickness of all water, oil and gas formations.

OIL, GAS OR WATER RECORDS

CASING RECORD

FORMATION	CONTENT	FROM	TO	SIZE	PUT IN	PULLED OUT
		0'	236'	8-5/8"	236'	None

Describe in detail the manner in which the well was plugged, indicating where the mud fluid was placed and the method or methods used in introducing it into the hole. If cement or other plugs were used, state the character of same and depth placed, from _____ feet to _____ feet for each plug set.

3740' - 225' Mud
225' - 221' Plug
221' - 6' Cement, 72 sacks (Bottom of cellar),
3 sacks cement in rat hole.

RECEIVED
STATE CORPORATION COMMISSION
AUG 18 1966

CONSERVATION DIVISION
Wichita, Kansas

(If additional description is necessary, use BACK of this sheet)

Name of Plugging Contractor United Cementing Co.
Address El Dorado, Kansas

STATE OF KANSAS, COUNTY OF SEDGWICK, ss.
John H. Knightley (employee of owner) or (owner or operator) of the above-described well, being first duly sworn on oath, says: That I have knowledge of the facts, statements, and matters herein contained and the log of the above-described well as filed and that the same are true and correct. (So help me God.)

(Signature) John H. Knightley
301 S. Broadway, Wichita, Kansas
(Address)

SUBSCRIBED AND SWORN TO before me this 16th day of August, 1966

My commission expires March 12, 1967

Stella J. Lippa
Notary Public.

Aylward Drilling Co.

Fanshier #1

SW NW NE Sec. 26-21S-13W
Stafford County, Kansas

Commenced: August 1, 1966

Completed: August 8, 1966

Rotary Drilling Contractor: Lauck Drilling Company, Incorporated

Casing Record: 236' 8-5/8" Cemented with 225 sacks Cement,
2-1/2% Calcium Chloride.

Elevation: GR 1869; DF 1872; KB 1875.

Drillers Log

Surface Clay	10
Sand & clay streaks	185
Shale	236
Shale, shell & red bed	730
Anhydrite	740
Shale & shells	1560
Lime & shale	1785
Lime w/shale streaks	2025
Lime	2155
Lime & shale	2255
Shale & lime	2680
Lime & shale	3020
Lime	3222
Shale & lime	3316
Lime	3625
Conglomerate	3692
Chert (Viola)	3740 RTD

RECEIVED
STATE CORPORATION COMMISSION
AUG 18 1966
CONSERVATION DIVISION
Wichita, Kansas