


STATE OF KANSAS
STATE CORPORATION COMMISSION

Form CP-4

WELL PLUGGING RECORD

Give All Information Completely
Make Required Affidavit
Mail or Deliver Report to:
Conservation Division
State Corporation Commission
212 No. Market
Wichita, Kansas

NORTH

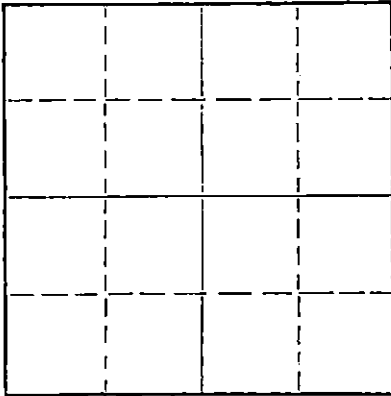

Locate well correctly on above
Section Plat

Stafford County, Sec. 26 Twp. 21 Rge. 13 (E) (W) x
Location as "NE/CNW%SW%" or footage from lines NE SE SE

Lease Owner Herman George Kaiser
Lease Name Batman "A" Well No. #2
Office Address Box 666, Ellinwood, Kansas
Character of Well (completed as Oil, Gas or Dry Hole)
Date well completed 19
Application for plugging filed 19
Application for plugging approved 19
Plugging commenced 8-17-66 19
Plugging completed 8-27-66 19
Reason for abandonment of well or producing formation

If a producing well is abandoned, date of last production 19
Was permission obtained from the Conservation Division or its agents before plugging was commenced?

Name of Conservation Agent who supervised plugging of this well Archie Elving
Producing formation Depth to top Bottom Total Depth of Well 3664' Feet
Show depth and thickness of all water, oil and gas formations.

OIL, GAS OR WATER RECORDS

CASING RECORD

FORMATION	CONTENT	FROM	TO	SIZE	PUT IN	PULLED OUT

Describe in detail the manner in which the well was plugged, indicating where the mud fluid was placed and the method or methods used in introducing it into the hole. If cement or other plugs were used, state the character of same and depth placed, from feet to feet for each plug set.

Made bottom hole plug back with sand to 3650', mixed and ran 5 sacks cement thru dump bailer.
Mudded hole to 200', set 10' rock bridge. Mixed and ran 5 sacks cement.
Filled hole with 2 1/2 yards ready mix from 180' to base of cellar.

RECEIVED
STATE CORPORATION COMMISSION

AUG 30 1966

W. C. Spencer
Notary Public

(If additional description is necessary, use BACK of this sheet)

Name of Plugging Contractor Southwest Casing Pulling Co., Inc.
Address Box 364, Great Bend, Kansas

STATE OF Kansas, COUNTY OF Barton, ss.
Southwest Casing Pulling Co., Inc. (employee of owner) or (owner or operator) of the above-described well, being first duly sworn on oath, says: That I have knowledge of the facts, statements, and matters herein contained and the log of the above-described well as filed and that the same are true and correct. So help me God.

(Signature) W. C. Spencer Sec.
Box 364, Great Bend, Kansas
(Address)

SUBSCRIBED AND SWORN to before me this 29 day of August, 19 66

My commission expires 24 October 1968
Sidney D. Miller
Notary Public.

LOG

Company: M. D. Armer et al
 Contractor: Judy Drilling Company, Inc.
 Drilling commenced: 1/13/50
 Drilling completed: 1/23/50
 Elevation: 1878 D. F. (1889 R. B.)

Well: Return - well #2
 Location: NE 22 21/4 Sec. 26-21-21,
 Stafford County, Kans.
 Casing record: 8-9/8" set @ 203'
 w/ 175 cords cement
 2 1/2" set @ 361'

(figures below indicate bottoms)

Sand, shale & chert	203
Shale & red bed	460
Red bed	710
Anhydrite	735
Shale & chert	1550
Shale & lime	1950
Broken lime	2140
Shale & chert	2550
Sand & lime	2720
Lime & shale	3025
Lime	3220
Shale & lime	3240
Shale	3285
Lime & shale	3350
Broken lime	3453
Shale & shale	3471
Lime	3555
Lime, chert	3592
Chert	3607
Shale, chert	3615
Shale	3621
Dolomite	3664
Total Depth - rotary	3664

RECEIVED
 STATE CORPORATION COMMISSION
 AUG 15 1966
 CORPORATION DIVISION
 Topeka, Kansas

FORMATION TOPS: (R. B. mean.)

Reamer shale	3172
Brown lime	3304
Lansing-Kansas City	3324
Viola	3570
Simpson	3606
Arbuckle	3661

I hereby certify that this is a true and correct log of the above described well as shown by the drilling reports.

JUDY DRILLING COMPANY, INC.

By M. D. Armer

STATE OF KANSAS }
 COUNTY OF REDWICK } SS

Subscribed and sworn to before me, a notary public, in and for said County and State this 30th day of January, 1950.

Henry Walton
 Notary Public