


Give All Information Completely
Make Required Affidavit
Mail or Deliver Report to:
Conservation Division
State Corporation Commission
212 North Market, Insurance Bldg.
Wichita, Kansas

WELL PLUGGING RECORD

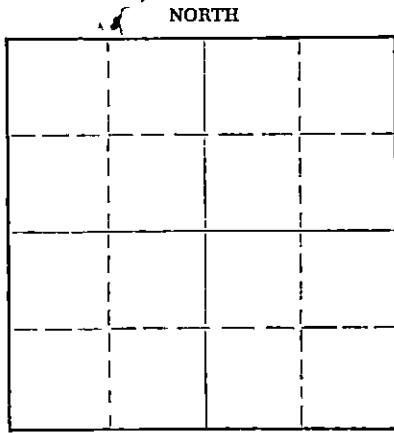

Locate well correctly on above Section Plat

Stafford County, Sec. 26 Twp. 21S Rge. 13 (W)
Location as "NE/CNW&SW?" or footage from lines W/2 W/2 SF
Lease Owner Herman George Kaiser
Lease Name Batman "D" Well No. 1
Office Address 909 Palace Bldg. Tulsa, Oklahoma
Character of Well (completed as Oil, Gas or Dry Hole) Dry Hole
Date well completed 11-17-60 19
Application for plugging filed 11-17-60 19
Application for plugging approved 11-17-60 19
Plugging commenced 11-17-60 19
Plugging completed 11-17-60 19
Reason for abandonment of well or producing formation Dry

If a producing well is abandoned, date of last production 19
Was permission obtained from the Conservation Division or its agents before plugging was commenced? Yes

Name of Conservation Agent who supervised plugging of this well Frank Broadfoot
Producing formation _____ Depth to top _____ Bottom _____ Total Depth of Well 3686 Feet
Show depth and thickness of all water, oil and gas formations.

OIL, GAS OR WATER RECORDS

CASING RECORD

FORMATION	CONTENT	FROM	TO	SIZE	PUT IN	PULLED OUT
				8-5/8"	275'	

Describe in detail the manner in which the well was plugged, indicating where the mud fluid was placed and the method or methods used in introducing it into the hole. If cement or other plugs were used, state the character of same and depth placed, from _____ feet to _____ feet for each plug set.

Bottom plug @ 400' w/20 sacks cement
Top plug @ 40' w/10 sacks cement and 1/2 sx. hulls

NOV 30 1960
CONSERVATION DIVISION
Wichita, Kansas

(If additional description is necessary, use BACK of this sheet)
Name of Plugging Contractor Leben Drilling, Inc.
Address 905 Central Bldg. Wichita 2, Kansas

STATE OF KANSAS, COUNTY OF SEDGWICK, ss.
Frank Hamlin (employee of owner) or (owner or operator) of the above-described well, being first duly sworn on oath, says: That I have knowledge of the facts, statements, and matters herein contained and the log of the above-described well as filed and that the same are true and correct. So help me God.

(Signature) Frank Hamlin
905 Central Bldg. Wichita 2, Kansas
(Address)

SUBSCRIBED AND SWORN to before me this 18th day of November, 19 60

My commission expires July 27, 1964

Bette J. Behymer
Bette J. Behymer Notary Public.



BULLER'S LOG

COMPANY:	HERRMAN GEORGE KAISER
CONTRACTOR:	LOBEN DRILLING, INC.
FARM:	BATMAN "D" #1
LOCATION:	E/2 W/2 S.E. SEC. 26-21S-13W.
	STAFFORD COUNTY, KANSAS
COMMENCED:	11-10-60
COMPLETED:	11-18-60

0	225	Sand
225	250	Blue Shale
250	275	Shale
275	1180	bedded & Shells
1180	1790	Shale & Lime
1790	1970	Lime & Shale
1970	2340	Lime & Shale
2340	2540	Lime & Shale
2540	2890	Lime & Shale
2890	3150	Lime & Shale
3150	3245	Lime & Shale
3245	3360	Lime & Shale
3360	3445	Lime
3445	3510	Lime
3510	3635	Lime & Shale
3635	3686	Lime & Shale
	<u>3686</u>	Rotary Total Depth - D & A

Set 8 5/8" surface casing @ 275' with 225 sacks Sunset cement.

I, Frank Hamlin, do hereby certify that the above and foregoing is a true and correct copy of the log of the Batman "D" #1, located E/2 W/2 SE of Section 26, Township 21 South, Range 13 West, Stafford County, Kansas, as reflected by the files of Loben Drilling, Inc.

RECEIVED
COMMISSION

Frank Hamlin
Frank Hamlin

NOV 30 1960

STATE OF KANSAS)
) SS COMMISSION DIVISION
 COUNTY OF SEDGWICK) Wichita, Kansas

Subscribed and sworn to before me, a Notary Public, in and for Sedgwick County, Kansas, this 23rd day of November, 1960.

Bette J. Behymer
Bette J. Behymer, Notary Public

My Commission Expires:
July 27, 1964