


WELL PLUGGING RECORD

Give All Information Completely
Make Required Affidavit
Mail or Deliver Report to:
Conservation Division
State Corporation Commission
800 Bitting Building
Wichita, Kansas

Stafford County. Sec. 26 Twp. 21 Rge. (E) 13 (W)
Location as "NE/CNWxSWx" or footage from lines NW NW SW/4
Lease Owner M. B. Armer
Lease Name D. Smith Well No. 4
Office Address 710 Petroleum Bldg., Wichita, Kansas
Character of Well (completed as Oil, Gas or Dry Hole) dry
Date well completed Sept. 12, 19 53
Application for plugging filed Sept. 12, 19 53
Application for plugging approved Sept. 12, 19 53
Plugging commenced Sept. 12, 19 53
Plugging completed Sept. 12, 19 53
Reason for abandonment of well or producing formation dry

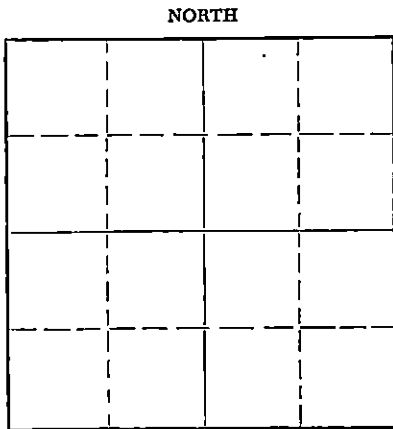

Locate well correctly on above
Section Flat

If a producing well is abandoned, date of last production 19
Was permission obtained from the Conservation Division or its agents before plugging was commenced? Yes

Name of Conservation Agent who supervised plugging of this well M. A. Rives
Producing formation Depth to top Bottom Total Depth of Well 3708 Feet
Show depth and thickness of all water, oil and gas formations.

OIL, GAS OR WATER RECORDS

CASING RECORD

FORMATION	CONTENT	FROM	TO	SIZE	PUT IN	PULLED OUT
				8 5/8"	289'	None

Describe in detail the manner in which the well was plugged, indicating where the mud fluid was placed and the method or methods used in introducing it into the hole. If cement or other plugs were used, state the character of same and depth placed, from feet to feet for each plug set.

Filled hole with heavy Rotary mud to 270 ft.
Set plug and ran 20 sacks cement through pipe,
mudded to 40 ft. set plug and ran 10 sacks cement
at the surface.

RECEIVED
STATE CORPORATION COMMISSION
9-25-53
SEP 25 1953
CONSERVATION DIVISION
Wichita, Kansas

Name of Plugging Contractor M. B. Armer
Address Wichita, Kansas

STATE OF KANSAS, COUNTY OF SEDGWICK, ss.
L. C. Sponenberg (employee of owner) or (owner or operator) of the above-described well, being first duly sworn on oath, says: That I have knowledge of the facts, statements, and matters herein contained and the log of the above-described well as filed and that the same are true and correct. So help me God.

(Signature) L. C. Sponenberg
(Address)

SUBSCRIBED AND SWORN TO before me this 24th day of September, 19 53

My commission expires February 13, 1956. Notary Public.

PLUGGING
FILED SEC 26 T 21 R 13W
BOOK PAGE 128 LINE 28

KANSAS WELL LOG BUREAU --- KANSAS GEOLOGICAL SOCIETY
508 EAST MURDOCK - WICHITA, KANSAS

COMPANY M. B. Armer

SEC. 26 T. 21S R. 13W

FARM Dottie Smith

NO. 4

LOC. NW NW SW

TOTAL DEPTH 3708'

COMM. 8/31/53


COMP. 9/12/53

COUNTY Stafford County
KANSAS

SHOT OR TREATED

CONTRACTOR M. B. Armer

ISSUED

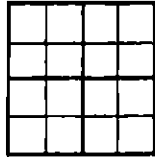

CASING

20	10	
15	8	289'
12	6	
13	5	

ELEVATION 1877 K.B.

PRODUCTION D & A

FIGURES INDICATE BOTTOM OF FORMATIONS

Clay	10
Sand	230
Shale & Shells	289
Red Bed	300
Red Bed & Shale & Sand	708
Anhydrite	735
Red Bed Shale & Shells	1215
Shale, Salt & Shells	1530
Lime	1655
Lime & Shale	1970
Lime	2055
Shale & Shells	2440
Shale	2575
Shale & Shells	2700
Shale & Lime	3120
Lime	3210
Shale & Lime	3335
Lime	3615
Lime, Shale & Chert	3658
Shale & Lime	3670
Lime	3708

FORMATION TOPS (K. B. Meas.)

BROWN LIME	3304
LANSING	3322
VIOLA	3576
SIMPSON	3630
ARBUCKLE	3676

I hereby certify that this is a true and correct log of the above described well as shown by the drilling reports.

M. B. ARMER

By *[Signature]*

STATE OF KANSAS
COUNTY OF SEDGWICK

Subscribed and sworn to before me, a notary public, in and for said County and State this 16th day of September, 1953.

[Signature]
Notary Public

My Commission expires February 13, 1956.

PLUGGING
WELL SEC 26 T 21 R 13W
BOOK PAGE 128 LINE 28

RECEIVED
STATE CORPORATION COMMISSION
SEP 25 1953
CONSERVATION DIVISION