


WELL PLUGGING RECORD

Give All Information Completely
Make Required Affidavit
Mail or Deliver Report to:
Conservation Division
State Corporation Commission
800 Pitting Building
Wichita, Kansas

NORTH

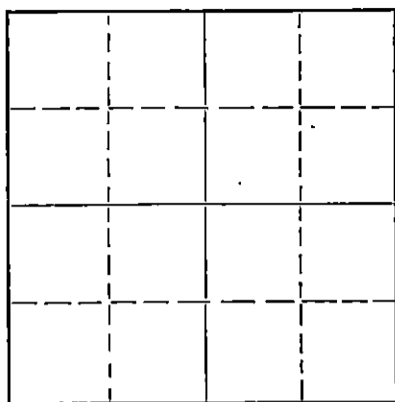

Locate well correctly on above Section Plat

Stafford County, Sec. 26 Twp. 21 Rge. (E) 13 (W)
Location as "NE/CNW/SW" or footage from lines. C W/2 W/2 SW/4
Lease Owner M. B. Armer
Lease Name Dottie Smith Well No. 1
Office Address 710 Petroleum Bldg., Wichita, Kans.
Character of Well (completed as Oil, Gas or Dry Hole) dry
Date well completed Oct. 19 48
Application for plugging filed Dec. 30 19 53
Application for plugging approved Dec. 30 19 53
Plugging commenced Jan. 3, 19 54
Plugging completed Jan. 7, 19 54
Reason for abandonment of well or producing formation Well depleted

If a producing well is abandoned, date of last production September 19 52
Was permission obtained from the Conservation Division or its agents before plugging was commenced? Yes

Name of Conservation Agent who supervised plugging of this well M. A. Reyes
Producing formation Arbuckle Depth to top 3648 Bottom 3651 Total Depth of Well 3652 Feet
Show depth and thickness of all water, oil and gas formations.

OIL, GAS OR WATER RECORDS

CASING RECORD

FORMATION	CONTENT	FROM	TO	SIZE	PUT IN	PULLED OUT
				8 5/8"	214	None
				5 1/2"	3649	2613'

Describe in detail the manner in which the well was plugged, indicating where the mud fluid was placed and the method or methods used in introducing it into the hole. If cement or other plugs were used, state the character of same and depth placed, from _____ feet to _____ feet for each plug set.

Plugging Report: R & S Pipe Pulling Co.

3349 to 3330 ft. Sand bridge
3330 to 3300 ft. 5 sacks cement
3300 to 210 ft. mudded
210 to 195 ft. rock bridge
195 to 150 ft. 20 sacks cement
150 to 35 ft. mud
35 to 20 cellar 10 sacks cement

(If additional description is necessary, use BACK of this sheet)

Name of Plugging Contractor R & S Pipe Pulling Company
Address Ellinwood, Kansas

STATE OF Kansas, COUNTY OF Sedgwich, ss.
L. C. Sponenberg (employee of owner) or (owner or operator) of the above-described well, being first duly sworn on oath, says: That I have knowledge of the facts, statements, and matters herein contained and the log of the above-described well as filed and that the same are true and correct. So help me God.

(Signature) *L. C. Sponenberg*
(Address)

SUBSCRIBED AND SWORN TO before me this 2 day of February, 19 54

My commission expires February 13, 1956.

Rose Lacey
Notary Public.

PLUGGING
FILE SEC 26 T 21 R 13W
BOOK PAGE 4 LINE 23

2-5-54

Company: M. B. Armer
 Contractor: Armer Drilling Company, Inc.
 Drilling Commenced: 9/22/48
 Drilling Completed: 10/6/48
 Elevation: 1875' D.F.
 Rotary Rig #1

Farm: Smith #1
 Location: C W $\frac{1}{2}$ W $\frac{1}{2}$ SW $\frac{1}{4}$ Sec. 26-21-13
 Stafford County, Kansas
 Casing Records:
 214' of 8 5/8" cemented w/170
 sax cement
 118 jts. of 5 1/2" set @ 3649'
 w/100 sax cement

(Figures below indicate bottom)

Sand & shale	212
Shale & Shells, red bed	350
Red bed, shale & shells	710
Anhydrite	725
Shale & shells	1240
Shale & lime	1295
Shale & shells	1490
Shale & shells & salt	1635
Lime & shale	2750
Broken lime	2820
Lime & shale	2965
Lime	3010
Broken lime	3045
Lime	3572
Lime, cherty	3601
Shale & lime	3625
Green shale	3648
Arbuckle	3651 T.D. - rotary

TOPS: (all rotary bushing measurements - 2' to D.F.)
 Heebner shale 3165
 Lansing Kansas City 3311
 Viola Chert 3564
 Simpson 3599
 Arbuckle 3648

I hereby certify that this is a true and correct log of the above described well as shown by the drilling reports.

ARMER DRILLING COMPANY, INC.

By M. B. Armer

State of Kansas |
 | SS
 County of Sedgwick |

Subscribed and sworn to before me, a notary public, in and for said County and State this 26th day of October.

Hazel Walton
 Notary Public

My commission expires Sept. 17, 1951

