

15.055.10149.0000

STATE OF KANSAS
STATE CORPORATION COMMISSION


WELL PLUGGING RECORD

FORMATION PLUGGING RECORD

Strike out upper line when reporting plugging of formations.

Give All Information Completely
Make Required Affidavit
Mail or Deliver Report to:
Conservation Division
State Corporation Commission
800 Bittling Building
Wichita, Kansas

NORTH

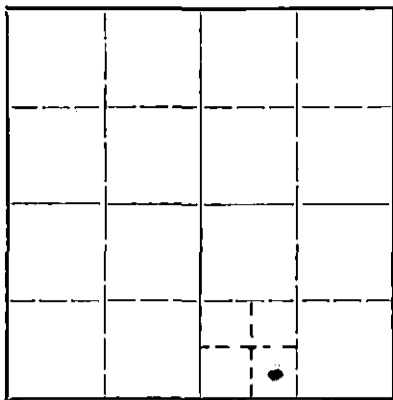

Locate well correctly on above Section Plat

Finney County. Sec. 22 Twp. 21S Rge. (E) 34 (W)
Location as "NE 1/4 NW 1/4 SW 1/4" or footage from lines C SE 1/4 SW 1/4 SE 1/4
Lease Owner The Shallow Water Refining Company
Lease Name Lockman Well No. 2
Office Address 114 West Pine St., Garden City, Kansas
Character of Well (completed as Oil, Gas or Dry Hole) Dry Hole
Date well completed (Moved off) November 30, 19 48
Application for plugging filed January 8, 19 51
Application for plugging approved January 10, 19 51
Plugging commenced February 15, 19 51
Plugging completed February 20, 19 51
Reason for abandonment of well or producing formation Non-commercial

If a producing well is abandoned, date of last production - 19
Was permission obtained from the Conservation Division or its agents before plugging was commenced? Yes

Name of Conservation Agent who supervised plugging of this well C. D. Stough
Producing formation - Depth to top - Bottom - Total Depth of Well 4716 Feet
Show depth and thickness of all water, oil and gas formations.

OIL, GAS OR WATER RECORDS

CASING RECORD

Formation	Content	From	To	Size	Put In	Pulled Out
Marmaton	Lime	4222'	4339'	5 1/2"	4630'	2604'
Mississippi	Lime	4590'	4712'			

Describe in detail the manner in which the well was plugged, indicating where the mud fluid was placed and the method or methods used in introducing it into the hold. If cement or other plugs were used, state the character of same and depth placed, from feet to feet for each plug set.

Lane Wells plug set at 4054'. Perforated from 4020' to 4034'.

Filled hole with coarse sand from 4054' to 4010'.

Dumped five sacks cement.

Mudded hole to 250'

Set ten foot rock bridge.

Ran fifteen sacks cement.

Filled hole with mud to 20' rock bridge and five sacks cement.

STATE CORPORATION COMMISSION
FEB 28 1951
Wichita, Kansas

(If additional description is necessary, use BACK of this sheet)

Correspondence regarding this well should be addressed to The Shallow Water Refining Company
Address 114 West Pine St.
Garden City, Kansas

STATE OF KANSAS, COUNTY OF FINNEY, ss.

Ben L. Kelley (employee of owner) of the above-described well, being first duly sworn on oath, says: That I have knowledge of the facts, statements, and matters herein contained and the log of the above-described well as filed and that the same are true and correct. So help me God.

(Signature) Ben L. Kelley
Garden City, Kansas (Address)

SUBSCRIBED AND SWORN to before me this 26th day of February, 19 51

My commission expires June 1, 1953
Notary Public

PLUGGING
FILE SEC 22 T 21 R 34
PAGE 54 LINE 4

W E L L L O G

Lockman No. 2

C SE $\frac{1}{4}$ SW $\frac{1}{4}$ SE $\frac{1}{4}$ Section 22-21S-34W
Finney County, Kansas

Commenced 9-20-48

Elevation - 2957'

Not completed - Moved off 11-30-48

Contractor - Adkins Drilling Co.

8 5/8" OD 25.55# surface casing set at 245' with 175 sacks cement
5 1/2" OD 15.5# and 14# casing set at 4601' with 254 sacks cement

<u>Formation</u>	<u>From</u>	<u>To</u>
Clay	0	30
clay & shale	30	250
shale & shells	250	590
shale	590	1185
red bed	1185	1345
anhydrite	1345	1365
red bed	1365	1475
anhydrite	1475	1500
red bed	1500	1550
red bed & shale	1550	2160
shale	2160	2655
lime-shale.	2655	3185
lime	3185	3210
shale	3210	3265
shale & lime	3265	3705
lime	3705	3895
lime - chert	3895	3930
lime	3930	3985
lime & shale	3985	4020
lime	4020	4060
lime & shale	4060	4165
lime	4165	4350
shale & lime	4350	4490
lime	4490	4520
shale & lime	4520	4540
lime - chert	4540	4555
lime	4555	4580
lime & shale	4580	4598
lime	4598	4716
Total depth		4716

STATE OF KANSAS)
) SS:
COUNTY OF FINNEY)

I hereby certify that the above Well Log is true and correct, to the best of my knowledge and belief.

Subscribed and sworn to before me this 8th day of January, 1951. Ben I. Kelly

My commission expires June 1, 1953.

PLUGGING
FILE SEC 21 21 34W
BOOK PAGE 54 LINE 9

Catherine Petersen
STATE CORPORATION COMMISSIONER
RECEIVED
JAN X 9 1951
CONSERVATION DIVISION
Wichita, Kansas