


WELL PLUGGING RECORD

Give All Information Completely
Make Required Affidavit
Mail or Deliver Report to:
Conservation Division
State Corporation Commission
800 Bittling Building
Wichita, Kansas

Finney County. Sec. 28 Twp. 21 Rge. 34 ~~X~~ W (W)
Location as "NE/CNW/SW" or footage from lines C E/2
Lease Owner Michaelis Drilling Co.
Lease Name Nunn Well No. 1
Office Address 1019 East Second St.
Character of Well (completed as Oil, Gas or Dry Hole) gas
Date well completed 9-5-55 19
Application for plugging filed 9-27-55 19
Application for plugging approved 9-28-55 19
Plugging commenced 10-8-55 19
Plugging completed 10-8-55 19
Reason for abandonment of well or producing formation No oil or gas

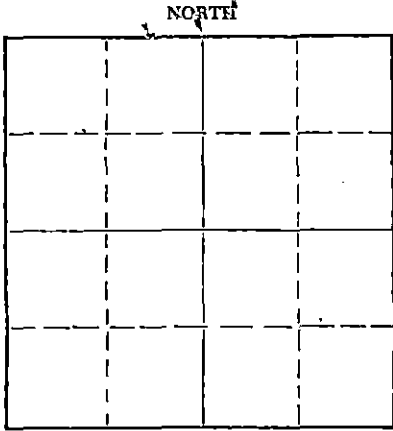

Locate well correctly on above
Section Plat

If a producing well is abandoned, date of last production none 19
Was permission obtained from the Conservation Division or its agents before plugging was commenced? yes

Name of Conservation Agent who supervised plugging of this well Merle Rives
Producing formation Chase group Depth to top 2500 Bottom 2610 Total Depth of Well 2610 Feet
Show depth and thickness of all water, oil and gas formations.

OIL, GAS OR WATER RECORDS

CASING RECORD

FORMATION	CONTENT	FROM	TO	SIZE	PUT IN	PULLED OUT
Shale & Sand	water	0	283	10-3/4	7-28-55	Cement circu- lated

Describe in detail the manner in which the well was plugged, indicating where the mud fluid was placed and the method or methods used in introducing it into the hole. If cement or other plugs were used, state the character of same and depth placed, from feet to feet for each plug set.

Plugged back with crushed rock from 2592' - 2490'
Dumped 5 sacks cement at 2490'. Top cement 2465.
Filled hole with mud to 290 ft. Set 10 ft. rock
bridge. Dumped 25 sacks cement. Top cement 250 ft.
Filled with mud to 35 ft., set rock bridge, dumped
15 caps cement for cap.

(If additional description is necessary, use BACK of this sheet)

Name of Plugging Contractor Earl Miller - (License #11)
Address Great Bend, Kansas

STATE OF KANSAS, COUNTY OF SEDGWICK, ss.
W. A. Michaelis, Jr. (employee of owner) or (owner or operator) of the above-described well, being first duly sworn on oath, says: That I have knowledge of the facts, statements, and matters herein contained and the log of the above-described well as filed and that the same are true and correct. So help me God.

(Signature) *W. A. Michaelis, Jr.*
1019 East Second St., Wichita, Ks.
(Address)

SUBSCRIBED AND SWORN TO before me this 14th day of October, 19 55

My commission expires 11-7-57
Mary L. Barnes Notary Public.

PLUGGING
FILE SEC 28 T 21 R 240
BOOK PAGE 4 LINE 10

RECEIVED
STATE CORPORATION COMMISSION
OCT 15 1955
CONSERVATION DIVISION
Wichita, Kansas

NO. 1 NUNN

Well Record

Location: Center E/2 Section 26-21S-34W
Finney County, Kansas

Commenced: July 28, 1955
Completed: August 1, 1955

Operator: Michaelis Drilling Company
1019 East Second Street
Wichita 7, Kansas

Contractor: Michaelis Drilling Company
1019 East Second Street
Wichita 7, Kansas

Casing Record: 10 - 3/4" @ 233' w/250 sacks cement
7 @ 2590' w/300 sacks cement

LOG

Sand - blue shale	284
Blue shale	540
Bentonite	560
Sand	720
Sandy shale	1100
Shale & red bed	1375
Gyp & streaks of iron	1478
Red bed & sand	1580
Salt & sand	1740
Red bed & gyp	1885
Shale & anhydrite	2592, RTD
Top of Herrington	2506'
Top of Krider	2544'

STATE OF KANSAS)
) ss.
COUNTY OF SEDGWICK)

The undersigned, Michaelis Drilling Company, hereby certifies that the above log is a true and correct log of the formations encountered in drilling the above well as reflected by the Daily Drilling Report.

MICHAELIS DRILLING COMPANY

By John L. James
John L. James, Geologist

Subscribed and sworn to before me
this 4th day of August, 1955.

Mary L. Baynes

Mary L. Baynes, Notary Public,
My comm. Expires: 11/7/57

RECEIVED
STATE GEOLOGICAL SURVEY
SEP 28 1955
CONSERVATION DIVISION
Wichita, Kansas

PLUGGING
FILE SEC 28 T 21 R 34 W
BOOK PAGE 10 LINE 4