


STATE OF KANSAS
STATE CORPORATION COMMISSION

Form CP-4

WELL PLUGGING RECORD

Give All Information Completely
Make Required Affidavit
Mail or Deliver Report to:
Conservation Division
State Corporation Commission
212 No. Market
Wichita, Kansas

NORTH

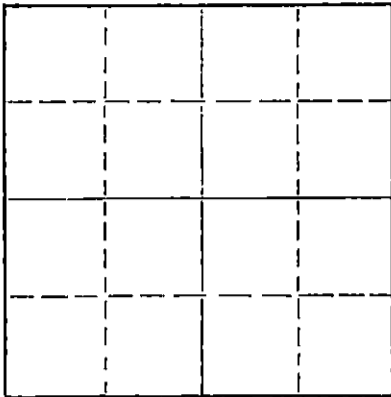

Locate well correctly on above
Section Plat

Stafford County. Sec. 35 Twp. 21 Rge. 13 (E) (W) X
Location as "NE/CNW%SW%" or footage from lines C N/2 NE NE
Lease Owner Kaiser-Francis
Lease Name Applegate Well No. #5
Office Address 909 Palace Bldg., Tulsa, Oklahoma
Character of Well (completed as Oil, Gas or Dry Hole)
Date well completed 19
Application for plugging filed 7-20-66 19
Application for plugging approved 19
Plugging commenced 8-9-66 19
Plugging completed 8-15-66 19
Reason for abandonment of well or producing formation

If a producing well is abandoned, date of last production 19
Was permission obtained from the Conservation Division or its agents before plugging was commenced?

Name of Conservation Agent who supervised plugging of this well Archie Elving
Producing formation Depth to top Bottom Total Depth of Well 3672' Feet
Show depth and thickness of all water, oil and gas formations.

OIL, GAS OR WATER RECORDS

CASING RECORD

FORMATION	CONTENT	FROM	TO	SIZE	PUT IN	PULLED OUT

Describe in detail the manner in which the well was plugged, indicating where the mud fluid was placed and the method or methods used in introducing it into the hole. If cement or other plugs were used, state the character of same and depth placed, from feet to feet for each plug set.

Made bottom hole plug back with sand to 3650', mixed and ran 5 sacks cement thru dump bailer.
Mudded hole to 280', set 10' rock bridge. Mixed and ran 5 sacks cement thru dump bailer. Filled hole with 3 1/2 yards ready mix from 260' to base of cellar.

RECEIVED
STATE CORPORATION COMMISSION
AUG 17 1966
CONSERVATION DIVISION
Wichita, Kansas

(If additional description is necessary, use BACK of this sheet)

Name of Plugging Contractor Southwest Casing Pulling Co., Inc.
Address Box 364, Great Bend, Kansas

STATE OF Kansas, COUNTY OF Barton, ss.

Southwest Casing Pulling Co., Inc. (employee of owner) or (owner or operator) of the above-described well, being first duly sworn on oath, says: That I have knowledge of the facts, statements, and matters herein contained and the log of the above-described well as filed and that the same are true and correct. So help me God.

(Signature) W. C. Spencer
Box 364, Great Bend, Kansas
(Address)

SUBSCRIBED AND SWORN to before me this 16 day of August, 1966

My commission expires 24 October 1968
Sidney D. Miller
Notary Public.

KANSAS GEOLOGICAL SOCIETY
 KANSAS WELL LOG BUREAU - KANSAS WELL SAMPLE BUREAU
 KANSAS GEOLOGICAL SOCIETY BUILDING
 508 EAST MURDOCK - WICHITA, KANSAS


15.185.01819.0000

COMPANY **Herman Geo. Kaiser & Francis Oil & Gas, Inc.**
 FARM **Appl- Gate** NO. **5**

SEC. **35** T. **21** R. **13W**
 LOC. **50' S C N/2 NE NE**

TOTAL DEPTH **3670'**
 COMM. **1/10/56** COMP. **1/23/56**
 SHOT OR TREATED
 CONTRACTOR **Armer, Inc.**
 ISSUED

COUNTY **Stafford**
 KANSAS

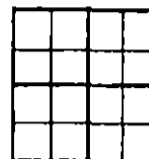

CASING
 20 10
 15 8 **278'**
 12 6
 13 5 **3667'**

ELEVATION **1878 K.B.**

PRODUCTION

FIGURES INDICATE BOTTOM OF FORMATIONS

Sand	165'
Shale & Shells	278
Red Pod	705
Anhydrite	728
Shale & Shells	1020
Shale, Shells & Salt	1340
Shale & Lime	2995
Broken Lime	3120
Lime	3167
Shale & Lime	3250
Shale	3314
Lime	3401
Lime & Shale	3446
Lime	3480
Lime & Shale	3490
Lime	3500
Shale	3547
Shale & Lime	3560
Lime & Chert	3598
Chert	3612
Shale	3640
Shale & Lime	3660
Lime	3670
Total depth	3672

FORMATION TOPS

HEEBNER 3173
 BROWN LIME 3297
 KANSAS CITY 3315
 ARBOCKLE 3655

I hereby certify that this is a true and correct log of the above described well as shown by the drilling reports.

ARMER, INC.

By *[Signature]*

STATE OF KANSAS)
) ss:
 COUNTY OF SEDGWICK)

Subscribed and sworn to before me, a notary public, in and for said County and State this 26th day of January, 1956.

[Signature]
 Notary Public

My Commission expires February 13, 1956.