


WELL PLUGGING RECORD

Give All Information Completely
Make Required Affidavit
Mail or Deliver Report to:
Conservation Division
State Corporation Commission
800 Biting Building
Wichita, Kansas

Stafford County. Sec. 35 Twp. 21S Rge. ~~12~~ 13 (W)

Location as "NE/CNW/WSW" or footage from lines NE NE NW
Lease Owner Magnolia Petroleum Company
Lease Name R. C. GATES Well No. 10
Office Address Box 900 - Dallas, Texas
Character of Well (completed as Oil, Gas or Dry Hole) Dry
Date well completed 3-29-54 19
Application for plugging filed 3-30-54 19
Application for plugging approved 3-31-54 19
Plugging commenced 4-5-54 19
Plugging completed 4-9-54 19
Reason for abandonment of well or producing formation Well drilled dry

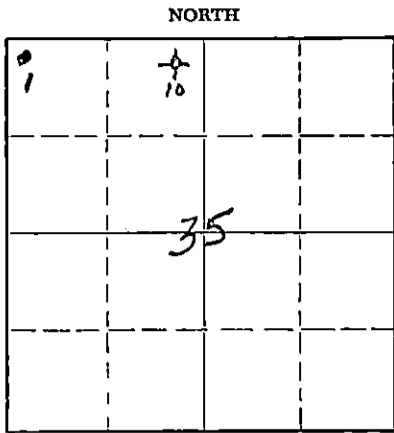

Locate well correctly on above Section Plat

If a producing well is abandoned, date of last production - 19
Was permission obtained from the Conservation Division or its agents before plugging was commenced? Yes

Name of Conservation Agent who supervised plugging of this well Mr. Rives
Producing formation None Depth to top Bottom Total Depth of Well 3728 Feet
Show depth and thickness of all water, oil and gas formations.

OIL, GAS OR WATER RECORDS

CASING RECORD

FORMATION	CONTENT	FROM	TO	SIZE	PUT IN	PULLED OUT
				8-5/8"	287'	None
				5-1/2"	3726'	2690'

Describe in detail the manner in which the well was plugged, indicating where the mud fluid was placed and the method or methods used in introducing it into the hole. If cement or other plugs were used, state the character of same and depth placed, from feet to feet for each plug set.

Plugged back with crushed rock to 3350'. Mixed and dumped 5 sx cement on top.
Mudded at approximately 1750'. Pulled 22 jts. 7" csg. Circulated hole with good
mud returns in cellar. Pulled remaining 7" csg. Bailed hole to 270'. Set 5' rock
bridge. Mixed and put in 20 sx cement. Loaded hole with mud to 35'. Set 5' rock
bridge. Mixed and put in 10 sx cement to base of cellar.

(If additional description is necessary, use BACK of this sheet)
Name of Plugging Contractor Ace Pipe Pulling Co.
Address Great Bend, Kansas

STATE OF KANSAS, COUNTY OF BARTON, SS. C. A. HILL (employee of owner) or (owner or operator) of the above-described well, being first duly sworn on oath, says: That I have knowledge of the facts, statements, and matters herein contained and the log of the above-described well as filed and that the same are true and correct. So help me God.

(Signature) [Signature]
Box 770 - Great Bend, Kansas
(Address)

SUBSCRIBED AND SWORN TO before me this 14th day of April, 19 54

My commission expires 1-14-57

[Signature] Notary Public.
RECEIVED
STATE CORPORATION COMMISSION
APR 29 1954
CONSERVATION DIVISION
Wichita, Kansas

24-267B-5 2-52-20M
PLUGGING
FILE SEC 35 T 21 R 13 W
BOOK PAGE 24 LINE 1

WELL LOG

15.185.11634.0000

R. C. GATES #10 (Drilled Dry & Abdn) Stafford County Chase District State of Kansas
NE NE NW Sec 35 - 21S - 13W 4½ miles East of Seward, Kansas

Drilling Commenced: 2/26/54 Brack Drilling Co, Wichita, Kansas - Rotary
Drilling Completed 3/30/54 Tompkins Drilling Co, Great Bend, Kansas - Cable Tools

8 5/8" csg 8RT 24.# 287' cem w/250 sx circ. 2/26/54
5 1/2" csg 8RT 15.5# 3726' cem w/200 sx 3/13/54

Elevation: 1878' KB Bradenhead to Kelly Bushing 8'

FORMATION:

Clay & Sand	0	80
Shale	80	175
Shale & Shells	175	289
Red Bed	289	400
Red Bed & Shale	400	695
Anhydrite	695	730
Shale & Shells	730	1165
Shale w/salt	1165	1475
Lime & Shale	1475	2105
Lime	2105	2260
Lime & Shale	2260	2545
Shale & Lime	2545	2695
Lime & Shale	2695	2915
Lime	2915	3220
Lime & Shale	3220	3330
Lime	3330	3525
Lime & Chert	3525	3588
Lime & Shale	3588	3695
Lime	3695	3705
Lime & Shale	3705	3728

Total Depth Drilled: 3728'
Oil String Set @: 3726'
Plug Back Depth: P & A 4/9/54

Size of Hole: 12 1/4" to 289' and 7 7/8" to 3728'

This well was drilled dry and temp. abd. 3/30/54. Well was plugged and abandoned on April 9, 1954 by Ace Pipe Pulling Company, Great Bend, Kansas.

RECEIVED
STATE CORPORATION COMMISSION
APR 29 1954
CONSERVATION DIVISION
Wichita, Kansas

PLUGGING
FILE SEC 35 T 21 R 19W
BOOK PAGE 24 LINE 1