

WELL PLUGGING RECORD

Give All Information Completely  
Make Required Affidavit  
Mail or Deliver Report to:  
Conservation Division  
State Corporation Commission  
800 Biting Building  
Wichita, Kansas

Stafford

County. Sec. 35 Twp. 21S Rge. 13 ~~13X~~ (W)

Location as "NE/CNW $\frac{1}{4}$ SW $\frac{1}{4}$ " or footage from lines SW NW NW

Lease Owner Magnolia Petroleum Company

Lease Name R.C. Gates Well No. 2

Office Address Box 770, Great Bend, Kansas

Character of Well (completed as Oil, Gas or Dry Hole) Dry hole

Date well completed September 28, 19 38

Application for plugging filed February 13, 19 51

Application for plugging approved February 14, 19 51


Plugging commenced February 27, 19 51

Plugging completed February 27, 19 51

Reason for abandonment of well or producing formation Dry hole, was holding for a salt water disposal well, developed later we did not need this hole

If a producing well is abandoned, date of last production \_\_\_\_\_ 19 \_\_\_\_\_

Was permission obtained from the Conservation Division or its agents before plugging was commenced? Yes

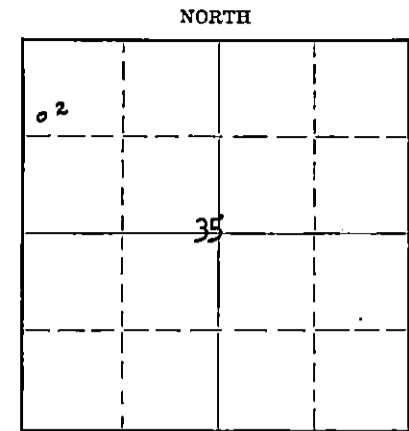

Locate well correctly on above Section Plat

Name of Conservation Agent who supervised plugging of this well Mr. C.D. Stough

Producing formation Arbuckle- Dry Depth to top 3703 Bottom 3730 Total Depth of Well 3730 Feet

Show depth and thickness of all water, oil and gas formations.

OIL, GAS OR WATER RECORDS

CASING RECORD

Formation	Content	From	To	Size	Put In	Pulled Out
None				13"	245'	None

Describe in detail the manner in which the well was plugged, indicating where the mud fluid was placed and the method or methods used in introducing it into the hole. If cement or other plugs were used, state the character of same and depth placed, from \_\_\_\_\_ feet to \_\_\_\_\_ feet for each plug set.

Total Depth of hole: 3730'; 13" surface casing was set @ 245' w/250 sx cement at time of drilling well in 1938. Hole was filled to surface with heavy rotary mud & screwed 13" Bull plug in 13" csg. & carried as temp. abd.

On Feb. 27, 1951, bailed hole down to 200' & plugged hole w/10 sx cement from 200' to 187', & filled with heavy rotary mud to 6' and filled up & cemented base of cellar w/5 sx cement, & welded bull plug on top of 13" casing.

RECEIVED  
STATE CORPORATION COMMISSION  
MAR - 1 1951  
CONSERVATION DIVISION  
Wichita, Kansas

(If additional description is necessary, use BACK of this sheet)

Correspondence regarding this well should be addressed to Mr. C.A. Hill, Magnolia Petroleum Co.  
Address Box 770, Great Bend, Kansas

STATE OF Kansas, COUNTY OF Barton, ss.  
C.A. Hill (employee of owner) or (owner)

being first duly sworn on oath, says: That I have knowledge of the facts, statements, and matters herein contained and the log of the above-described well as filed and that the same are true and correct. So help me God.

(Signature) *C.A. Hill*

Box 770, Great Bend, Kansas

(Address)

SUBSCRIBED AND SWORN to before me this 28th day of February, 19 51

My commission expires October 15, 1953

22-7377-s 4-40-10M

*Fay Richardson*  
Notary Public.

PLUGGING  
FILE SEC 35 T 21 R 13W  
BOOK PAGE 64 LINE 25

MAGNOLIA PETROLEUM COMPANY

R.C. GATES #2  
 SW NW NW, Sec. 35-21S-13W  
 Gates Field, Stafford County, Kan.

LOG OF WELL

PLUGGING STARTED: Feb. 27, 1951  
 PLUGGING COMPLETED: Feb. 27, 1951

CASING RECORD  
 13"

PUT IN  
 245'

PULLED OUT  
 None

Well Plugged & Abandoned by: Magnolia Petroleum Co. (Pulling Unit), Great Bend, Kan.

ELEV: 1879'

FORMATION	TOP	BOTTOM
Cellar	0	8
Sand & clay	8	30
Sand	30	100
Shale & red rock	100	250
Shale & shells	250	1140
Set 13" csg. @ 245' w/250 sx cem circ.		
Salt & shale	1140	1195
Shale	1195	1205
Salt	1205	1500
Lime	1500	1518
Lime & shale	1518	1930
Sand & lime	1930	1965
Shale & lime	1965	2395
Shale	2395	2560
Shale & lime	2560	2695
Lime	2695	2735
Lime & shale	2735	2820
Lime	2820	2905
Shale & lime	2905	2990
Sticky shale	2990	3010
Lime	3010	3315
Shale	3315	3325
Lime (Lansing KC)	3325	3555
Lime & shale	3555	3595
Shale	3595	3654
Lime (Viola)	3654	3683
Sand (Simpson)	3683	3703
Lime(Arbuckle)	3703	3730
TD:		3730'

COMPLETION HISTORY:

Took DST: 3705-30' w/wall packer @ 3705', Tool open 30 min, Rec. 300' Sulphur water & 30' Drlg. mud. Hole pumped full of rotary mud and screwed bull plug in 13" casing. - Temp. Abd.

PLUGGING RECORD:

Bailed hole down to 200' & plugged hole w/10 sx cement from 200' to 187'; & filled with heavy rotary mud to 6' and filled up & cemented base of cellar w/5 sx cement, & welded bull plug on top of 13" casing.

RECEIVED  
 STATE CORPORATION COMMISSION  
 MAR - 1 1951  
 CONSERVATION DIVISION  
 Wichita, Kansas

PLUGGING  
 FILE SEC 35-21S-13W  
 BOOK PAGE 61-25

## MAGNOLIA PETROLEUM COMPANY

R.C. GATES #2  
 SW NW NW, Sec. 35-21S-13W  
 Gates Field, Stafford County, Kan.

LOG OF WELL

PLUGGING STARTED: Feb. 27, 1951  
 PLUGGING COMPLETED: Feb. 27, 1951

CASING RECORD  
 13"

PUT IN  
 245'

PULLED OUT  
 None

Well Plugged & Abandoned by: Magnolia Petroleum Co. (Pulling Unit), Great Bend, Kan.

ELEV: 1879'

<u>FORMATION</u>	<u>TOP</u>	<u>BOTTOM</u>
Cellar	0	8
Sand & clay	8	30
Sand	30	100
Shale & red rock	100	250
Shale & shells	250	1140
Set 13" csg. @ 245' w/250 sx cem circ.		
Salt & shale	1140	1195
Shale	1195	1205
Salt	1205	1500
Lime	1500	1518
Lime & shale	1518	1930
Sand & lime	1930	1965
Shale & lime	1965	2395
Shale	2395	2560
Shale & lime	2560	2695
Lime	2695	2735
Lime & shale	2735	2820
Lime	2820	2905
Shale & lime	2905	2990
Sticky shale	2990	3010
Lime	3010	3315
Shale	3315	3325
Lime (Lansing KC)	3325	3555
Lime & shale	3555	3595
Shale	3595	3654
Lime (Viola)	3654	3683
Sand (Simpson)	3683	3703
Lime(Arbuckle)	3703	3730
TD:		3730'

COMPLETION HISTORY:

Took DST: 3705-30' w/wall packer @ 3705', Tool open 30 min, Rec. 300' Sulphur water & 30' Drlg. mud. Hole pumped full of rotary mud and screwed bull plug in 13" casing. - Temp. Abd.

PLUGGING RECORD:

Bailed hole down to 200' & plugged hole w/10 sx cement from 200' to 187'; & filled with heavy rotary mud to 6' and filled up & cemented base of cellar w/5 sx cement, & welded bull plug on top of 13" casing.

**RECEIVED**  
 STATE CORPORATION COMMISSION  
 MAR - 1 1951  
 CONSERVATION DIVISION  
 Wichita, Kansas

**PLUGGING**  
 FILE REG—T—R—  
 BOOK PAGE—LOW—