


STATE OF KANSAS
STATE CORPORATION COMMISSION

Give All Information Completely
Make Required Affidavit
Mail or Deliver Report to:
Conservation Division
State Corporation Commission
212 No. Market
Wichita, Kansas

WELL PLUGGING RECORD

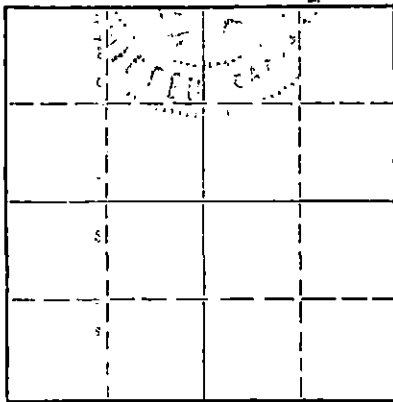

Locate well correctly on above
Section Plat

Ellis County. Sec. 28 Twp. 14 Rge. 19W (E) (W)

Location as "NE/CNW%SW%" or footage from lines NW SE SE

Lease Owner Commercial Oil, Inc

Lease Name Feitz Well No. 1

Office Address 5252 N. Broadway Wichita, Kansas

Character of Well (completed as Oil, Gas or Dry Hole) Oil

Date well completed _____ 19 _____

Application for plugging filed 9/10/ 19 68

Application for plugging approved 9/10/ 19 68

Plugging commenced 9/13/ 19 68

Plugging completed 9/21/ 19 68

Reason for abandonment of well or producing formation Dry

If a producing well is abandoned, date of last production _____ 19 _____

Was permission obtained from the Conservation Division or its agents before plugging was commenced? Yes

Name of Conservation Agent who supervised plugging of this well Leo Massey

Producing formation _____ Depth to top _____ Bottom _____ Total Depth of Well 3761 Feet

Show depth and thickness of all water, oil and gas formations.

OIL, GAS OR WATER RECORDS

CASING RECORD

FORMATION	CONTENT	FROM	TO	SIZE	PUT IN	PULLED OUT
				<u>4 1/2"</u>	<u>3669</u>	<u>3011</u>
				<u>8 5/8"</u>	<u>234</u>	<u>None</u>

Describe in detail the manner in which the well was plugged, indicating where the mud fluid was placed and the method or methods used in introducing it into the hole. If cement or other plugs were used, state the character of same and depth placed, from _____ feet to _____ feet for each plug set.

Plugged off bottom with sand ran 4 sacks cement through dump bailer 3425'

Squeezed hole by mixing and pumping 4 sacks hulls followed by 6 sacks of Gel.

Mixed and pumped 19 sacks Gel displaced with 130 sacks cement with 6% Gel.

RECEIVED
STATE CORPORATION COMMISSION
SEP 24 1968
CONSERVATION DIVISION
Wichita, Kansas

(If additional description is necessary, use BACK of this sheet)

Name of Plugging Contractor Southwest Casing Pulling Co., Inc

Address Box 364, Great Bend, Kansas 67530

STATE OF Kansas, COUNTY OF Barton, ss.
W. C. Spencer

(employee of owner) or (owner or operator) of the above-described well, being first duly sworn on oath, says: That I have knowledge of the facts, statements, and matters herein contained and the log of the above-described well as filed and that the same are true and correct. So help me God.

(Signature) W C Spencer Sec

Great Bend, Kansas 67530

(Address)

Subscribed and sworn to before me this 23 day of September, 19 68

My commission expires 24 October 1968

Sidney D Miller
Notary Public.

