


STATE OF KANSAS  
STATE CORPORATION COMMISSION

Form CP-4

WELL PLUGGING RECORD

Give All Information Completely  
Make Required Affidavit  
Mail or Deliver Report to:  
Conservation Division  
State Corporation Commission  
212 No. Market  
Wichita, Kansas

NORTH

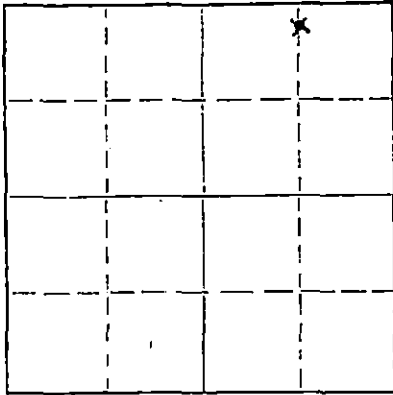

Locate well correctly on above  
Section Plat

Ellis County. Sec. 22 Twp. 14S Rge. (E) 19 (W)  
Location as "NE/CNW/SW" or footage from lines C N/2 N/2 NE/4  
Lease Owner L.J. Dreiling & Sons, Inc.  
Lease Name Johnson B Well No. 1  
Office Address Victoria, Kansas  
Character of Well (completed as Oil, Gas or Dry Hole) dry hole  
Date well completed 7-21-66 19 66  
Application for plugging filed 7-21 19 66  
Application for plugging approved 7-21 19 66  
Plugging commenced 11:30 A.M. 19 66  
Plugging completed 2:00 P.M. 19 66  
Reason for abandonment of well or producing formation Dry Hole

If a producing well is abandoned, date of last production none 19 66  
Was permission obtained from the Conservation Division or its agents before plugging was commenced? yes

Name of Conservation Agent who supervised plugging of this well Leo Massey, Hays, Kansas  
Producing formation none Depth to top Bottom Total Depth of Well 3822 Feet  
Show depth and thickness of all water, oil and gas formations.

OIL, GAS OR WATER RECORDS

CASING RECORD

FORMATION	CONTENT	FROM	TO	SIZE	PUT IN	PULLED OUT
Surface Clay & Shale		0	206	8 5/8"	206	none

Describe in detail the manner in which the well was plugged, indicating where the mud fluid was placed and the method or methods used in introducing it into the hole. If cement or other plugs were used, state the character of same and depth placed, from \_\_\_\_\_ feet to \_\_\_\_\_ feet for each plug set.

~~Filled hole with mud to 211' / Set Plug at 540' and cemented with 20 sacks through drill pipe. Filled hole to 200'. Set plug with hulls and cemented with 20 sacks through drill pipe. Fill hole to 40' made bridge to hold kelly weight, plugged with 10 sacks. Plugged rat hole with 2 sacks.~~

JUL 26 1966  
CONSERVATION DIVISION  
Wichita, Kansas

(If additional description is necessary, use BACK of this sheet)

Name of Plugging Contractor B & B DRILLING INC.  
Address 548 Petroleum Building, Wichita, Kansas

STATE OF Kansas, COUNTY OF Sedgwick, ss.  
Bill Lahar (President) (employee of owner) or (owner or operator) of the above-described well, being first duly sworn on oath, says: That I have knowledge of the facts, statements, and matters herein contained and the log of the above-described well as filed and that the same are true and correct. So help me God.

(Signature) Bill Lahar  
548 Petroleum Building, Wichita, Kansas  
(Address)

SUBSCRIBED AND SWORN TO before me this 25th day of July, 19 66

My commission expires May 31, 1970  
Alma A. Neises Notary Public.

**B & B DRILLING, INC.**

548 Petroleum Building

Wichita, Kansas 67202

July 25, 1966

DRILLERS LOG

Re: Johnson B #1  
 C N/2 N/2 NE/4  
 Sec 22-14S-19W  
 Ellis County, Kansas

COMPANY: Leo J. Drilling & Sons, Inc.  
 CONTRACTOR: B & B Drilling Inc.  
 TOTAL DEPTH: 3822'  
 COMMENCED: 7-14-66  
 COMPLETED: 7-21-66

RECEIVED  
 CONSERVATION COMMISSION  
 JUL 26 1966  
 CONSERVATION DIVISION  
 Wichita, Kansas

0	206	Clay and shale (surface hole)	150 sacks
206	1418	Shale	
1418	1436	Anhydrite	
1436	2530	Shale and shells	
2530	3500	Lime and shale	
3500	3671	Lime ( Kansas City)	
3671	3761	Shale and Lime	
3761	3822	Lime (Arbuckle)	
	3822	Total Depth	D & A

We certify the above and foregoing to be true and correct copy of the log on the #1 Johnson, located in Ellis County, Kansas

B &amp; B DRILLING, INC.

Bill Palan President

Alma A. Nuses  
 Notary Public

Subscribed and sworn to before me this 25th day of July, 1966

My commission expires May 31, 1970