

WELL PLUGGING RECORD

STATE OF KANSAS  
STATE CORPORATION COMMISSION


Give All Information Completely  
Make Required Affidavit  
Mail or Deliver Report to:  
Conservation Division  
State Corporation Commission  
800 Bitting Building  
Wichita, Kansas

OR  
FORMATION PLUGGING RECORD

Strike out upper line  
when reporting plug-  
ging of formations.

Ellis County. Sec. 6 Twp. 14 Rge. 19 (X) W (W)  
Location as "NE1/4NW1/4SW1/4" or footage from lines. NW/4 NW/4 NW/4  
Lease Owner Prime Drilling Company, et al  
Lease Name Strohmeier Well No. 1  
Office Address 3111 Apco Tower, Oklahoma City, Oklahoma  
Character of Well (completed as Oil, Gas or Dry Hole) Dry Hole  
Date well completed 19...  
Application for plugging filed January 20 19 50  
Application for plugging approved January 20 19 50  
Plugging commenced January 20 19 50  
Plugging completed January 20 19 50  
Reason for abandonment of well or producing formation Dry Hole

NORTH

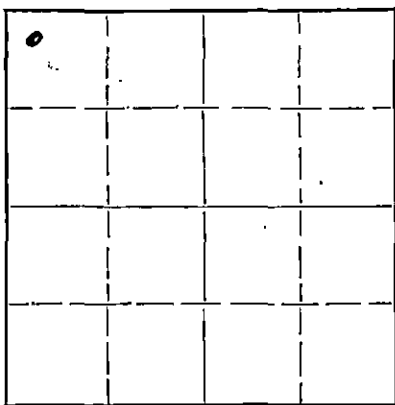

Locate well correctly on above  
Section Plat

Name of Conservation Agent who supervised plugging of this well Mr. Eldon Petty  
Producing formation Depth to top Bottom Total Depth of Well 3966 Feet  
Show depth and thickness of all water, oil and gas formations.

OIL, GAS OR WATER RECORDS

CASING RECORD

Formation	Content	From	To	Size	Put In	Pulled Out
				8 5/8"	161'	0'
				5"	3950'	3116'

Describe in detail the manner in which the well was plugged, indicating where the mud fluid was placed and the method or methods used in introducing it into the hole. If cement or other plugs were used, state the character of same and depth placed, from feet to feet for each plug set.

Baker Plug Set at 3650', plugged back with Chat. from 3650' to 3610'. Dumped 5 sacks cement w/dump bailer at 3610'. Plugged back to 164' with heavy drilling mud. Dumped 15 sacks of cement on 10' rock bridge at 164', heavy mud to 32', filled hole to bottom of cellar with 10 sacks cement.

RECEIVED

FEB 4 X 1950

2-4-50

STATE CORPORATION COMMISSION

(If additional description is necessary, use BACK of this sheet)

Correspondence regarding this well should be addressed to Prime Drilling Company  
Address 3111 Apco Tower, Oklahoma City, Oklahoma

STATE OF OKLAHOMA, COUNTY OF OKLAHOMA, ss.

L. J. Kruse (employee of owner) or (owner or operator) of the above-described well, being first duly sworn on oath, says: That I have knowledge of the facts, statements, and matters herein contained and the log of the above-described well as filed and that the same are true and correct. So help me God.

(Signature) L. J. Kruse

3111 Apco Tower, Oklahoma City, Okla. (Address)

SUBSCRIBED AND SWORN to before me this 3rd day of February, 1953

Margaret Peger

Notary Public.

My commission expires 11-17-53

PLUGGING  
FILE SEC 67-14-R-196  
BOOK PAGE 135-21

PRIME DRILLING COMPANY ET AL.  
 STROHMEIER NO. 1  
 NW/4 NW/4 NW/4, Sec. 6-14S-19W,  
 Ellis County, Kansas

<u>Formations</u>	<u>From</u>	<u>To</u>	<u>Remarks</u>
Sand Rock & Clay	0	40	
Shale & Shells	40	161	8 5/8" C.S.A. 161* W/100 sacks cement
Shale & Shells	161	220	
Shale	220	600	
Red Bed, Shale & Shells	600	1050	
Sand	1050	1260	
Shale & Shells	1260	1340	
Red Bed & Shells	1340	1565	
Anhydrite	1565	1610	
Red Bed, Shale & Shells	1610	1720	
Shale & Shells	1720	2000	
Salt	2000	2140	
Shale & Shells	2140	2300	
Shale & Lime	2300	2600	
Lime	2600	2670	
Shale, Lime & Shells	2670	2825	
Shale & Lime	2825	3040	
Lime & Shale	3040	3190	
Shale & Lime	3190	3300	
Lime & Shale	3300	3370	
Lime	3370	3450	
Shale & Lime	3450	3465	
Lime	3465	3622	
Lime & Shale	3622	3655	
Lime	3655	3845	
Lime, Shale & Chert	3845	3900	
Lime	3900	3920	
Sand & Chert	3920	3936	
Lime	3936	3950	5 1/2 " C.S.A. 3950* W/150 sacks cement.
Total Depth - Rotary		3950	
Lime (cable tools)	3950	3966	

I hereby certify the foregoing to be a true and accurate Driller's Log of the formations encountered in the above well.

PRIME DRILLING COMPANY

By L.J. Kruse  
 L.J. Kruse, Asst. Secy.

Subscribed and sworn to before me this 24th day of January, 1950.

Hazel Carley  
 Notary Public

RECEIVED

FEB 4 X 1950

DRILLING  
 SEC. 6-14S-19W  
 135-21

My commission expires:  
 March 13, 1953