

STATE OF KANSAS
STATE CORPORATION COMMISSION


WELL PLUGGING RECORD

OR
FORMATION PLUGGING RECORD

Strike out upper line
when reporting plug-
ging off formations.

Give All Information Completely
Make Required Affidavit
Mail or Deliver Report to:
Conservation Division
State Corporation Commission
800 Bitting Building
Wichita, Kansas

NORTH

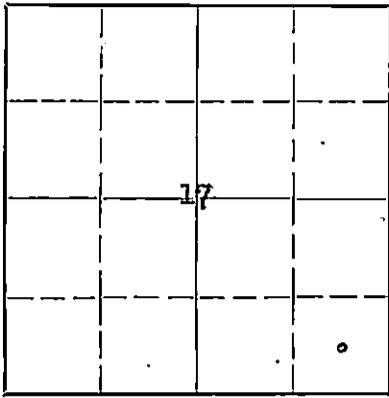

Locate well correctly on above
Section Plat

Ellis County, Sec. 17 Twp. 14S Rge. (26) 20 (W)
Location as "NE1/4NW1/4SW1/4" or footage from lines SE SE SE
Lease Owner Bridgeport Oil Company, Inc.
Lease Name Markey "C" Well No. I
Office Address 918 Central Building - Wichita 2, Kansas
Character of Well (completed as Oil, Gas or Dry Hole) Dry Hole
Date well completed 8 - 26 19 44
Application for plugging filed 8 - 26 19 44
Application for plugging approved 8 - 26 19 44
Plugging commenced 8 - 26 19 44
Plugging completed 8 - 26 19 44
Reason for abandonment of well or producing formation Dry Hole

If a producing well is abandoned, date of last production 19
Was permission obtained from the Conservation Division or its agents before plugging was com-
menced? Yes

Name of Conservation Agent who supervised plugging of this well Ruel Durkee
Producing formation Depth to top Bottom Total Depth of Well 3862 Feet
Show depth and thickness of all water, oil and gas formations.

OIL, GAS OR WATER RECORDS

CASING RECORD

Formation	Content	From	To	Size	Put In	Pulled Out
				8-5/8"	119' with 75 sacks bulk cement.	None

Describe in detail the manner in which the well was plugged, indicating where the mud fluid was placed and the method or methods used in introducing it into the hold. If cement or other plugs were used, state the character of same and depth placed, from feet to feet for each plug set.

Filled hole with heavy mud 3862' to 119'
Set plug @ 119' with 20 sacks cement
Filled hole with heavy mud to 30'
Set plug @ 30' and cemented on top of plug with 11 sacks to within 6' of top

PLUGGING
FILE NO. 17 14-R-200W
BOOK PAGE 29 LINE 21

(If additional description is necessary, use BACK of this sheet)

Correspondence regarding this well should be addressed to Bridgeport Oil Company, Inc.,
Address 918 Central Building - Wichita 2, Kansas.

STATE OF Kansas COUNTY OF Sedgwick, ss.
Frank Leach (employee of owner) or (owner or operator) of the above-described well,
being first duly sworn on oath, says: That I have knowledge of the facts, statements, and matters herein contained and the log of the above-described well as filed and that the same are true and correct. So help me God.

(Signature) *Frank Leach*
Wichita, Kansas
(Address)

SUBSCRIBED AND SWORN TO before me this 1st day of September 1944
Virginia Boop Notary Public

My commission expires October 29, 1947

BRIDGEPORT OIL COMPANY, INC.,
918 CENTRAL BUILDING,
WICHITA 2, KANSAS.

Well Log-----Markey "C" #1
SE SE SE 17-14S-20W
Ellis County, Kansas

Elevation-----2129 I&S
Date Started----8-4-44
Date Completed--8-26-44

Casing Record:-
8-5/8" casing cemented @ 119'
with 75 sacks bulk cement.

Rotary Tools----0 to 3862'

LOG

0	10	Cellar
10	25	Gravel
25	75	Clay
75	120	Shale
120	225	Blue & Black Shale
225	270	Sand Rock & Shale
270	400	Shale & Shells
400	580	Sand
580	750	Shale
750	825	Shale & Pyrite
825	880	Shale & Shells
880	1105	Sand
1105	1130	Shale
1130	1322	Red Bed & Shale
1322	1446	Shale & Red Bed
1446	1477	Lime & Shale
1477	1550	Shale & Shells
1550	1765	Shale & Red Rock
1765	1840	Shale
1840	2040	Salt
2040	2090	Shale & Shells
2090	2215	Shale
2215	2280	Lime & Shale
2280	2320	Shale
2320	2374	Shale & Shells & Iron
2374	2440	Shale
2440	2465	Lime
2465	2515	Shale & Lime
2515	2575	Lime & Shale
2575	2595	Sand & Lime
2595	2615	Lime, Shale & Sand
2615	2800	Shale & Shells
2800	3050	Lime & Shale
3050	3100	Lime
3100	3165	Lime & Shale
3165	3285	Lime
3285	3356	Lime & Shale
3356	3458	Lime
3458	3510	Lime & Shale
3510	3521	Lime
3521	3545	Lime & Chert
3545	3597	Lime & Shale
3597	3605	Lime
3605	3623	Lime & Shale
3623	3690	Lime
3690	3701	Lime & Shale
3701	3738	Lime, Shale & Chert
3738	3758	Shale, Chert & Lime
3758	3794	Lime, Shale & Chert
3794	3818	Shale & Chert
3818	3833	Lime
3833	3856	Hard Lime & Sand
3856	3859	Broken Lime
3859	3862	Lime
3862		T.D.

Plugged & Abandoned 8-26-44

FORMATION TOPS - DF

Top Heebner	3402'
Top Toronto	3427'
Top Lansing	3441'
Base K.C.	3693'
Top Conglomerate	3769'
Top Arbuckle	3816'

I, Frank Leach, do hereby certify
that the above log is correct to the
best of my knowledge and belief.

BRIDGEPORT OIL COMPANY, INC.

By: Frank Leach

