


STATE OF KANSAS
STATE CORPORATION COMMISSION

WELL PLUGGING RECORD

Give All Information Completely
Make Required Affidavit
Mail or Deliver Report to:
Conservation Division
State Corporation Commission
211 No. Broadway
Wichita, Kansas

Ellis County. Sec. 29 Twp. 15 Rge. (E) 20 (W)
Location as "NE/CNW/SW" or footage from lines NW NW NW 1/4
Lease Owner Don E. Pratt
Lease Name Harley G. North Well No. 3
Office Address Box 656 Hays, Kansas
Character of Well (completed as Oil, Gas or Dry Hole) Dry
Date well completed July 24, 19 57
Application for plugging filed July 24, 19 57
Application for plugging approved July 24, 19 57
Plugging commenced July 24, 19 57
Plugging completed July 24, 19 57
Reason for abandonment of well or producing formation Dry

NORTH

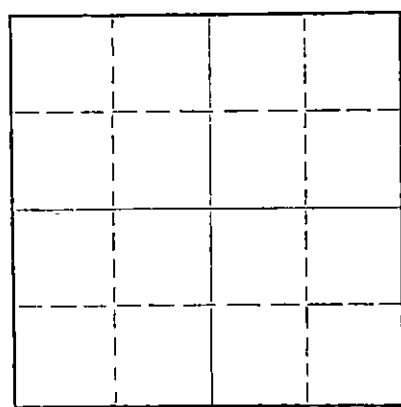

Locate well correctly on above
Section Plat

If a producing well is abandoned, date of last production 19
Was permission obtained from the Conservation Division or its agents before plugging was commenced? Yes

Name of Conservation Agent who supervised plugging of this well Eldon Petty
Producing formation _____ Depth to top _____ Bottom _____ Total Depth of Well 3,958 Feet
Show depth and thickness of all water, oil and gas formations.

OIL, GAS OR WATER RECORDS

CASING RECORD

FORMATION	CONTENT	FROM	TO	SIZE	PUT IN	PULLED OUT
				8-5/8	250	None

Describe in detail the manner in which the well was plugged, indicating where the mud fluid was placed and the method or methods used in introducing it into the hole. If cement or other plugs were used, state the character of same and depth placed, from _____ feet to _____ feet for each plug set.

Filled hole with heavy rotary mud to 560', set plug and cemented with 25 sacks cement through drill pipe. Filled with heavy rotary mud to 40', set plug and cemented with 10 sacks cement and 1/2 sack hulls to surface.

(If additional description is necessary, use BACK of this sheet)

Name of Plugging Contractor H-30, Inc.
Address 710 Petroleum Bldg., Wichita, Kansas.

STATE OF Kansas COUNTY OF Sedgwick
L. C. Sponenberg (employee of contractor) of the above-described well, being first duly sworn on oath, says: That I have knowledge of the facts, statements, and matters herein contained and the log of the above-described well as filed and that the same are true and correct. So help me God.

(Signature) [Signature]
(Address) _____

SUBSCRIBED AND SWORN to before me this 29th day of July, 19 57

My commission expires February 13, 1960

Rose Turey
RECEIVED Notary Public.
STATE CORPORATION COMMISSION

PLUGGING
FILE SEC 29 T. 15 R. 20w
BOOK PAGE 31 LINE 14

AUG 1 1957

CONSERVATION DIVISION

15.051-04718.00.00

KANSAS GEOLOGICAL SOCIETY
KANSAS WELL LOG BUREAU - KANSAS WELL SAMPLE BUREAU
KANSAS GEOLOGICAL SOCIETY BUILDING
508 EAST MURDOCK - WICHITA, KANSAS


COMPANY Don E. Fratt
FARM Harley G. North NO. 3

SEC. 29 T. 15 R. 20W
LOC. NW NW NW

TOTAL DEPTH 3,958 Ft.
COMM. 7/11/57 COMP. 7/24/57
SHOT OR TREATED
CONTRACTOR H-30, Inc.
ISSUED

COUNTY Ellis

KANSAS

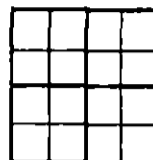

CASING
20 10
15 8 250'
12 6
13 5

ELEVATION 2,197' D.F.
2,200' K.E.

PRODUCTION D & A

FIGURES INDICATE BOTTOM OF FORMATIONS

Top soil	5
Clay & rock	45
Shale w/sand streaks	85
Shale	431
Sand	417
Shale	494
Shale & shells	570
Shale	715
Shale w/sand streaks	830
Top L. Sand	1,010
Red Bed	1,190
Shale & shells (red bed)	1,458
Anhydrite	1,502
Shale & shells	1,740
Shale w/lime streaks	1,804
Shale & limo	2,435
Lime	2,510
Lime & shale	3,544
Kansas City Lime	3,850
Lime shale	3,871
Lime & chert	3,958

FORMATION TOPS:

Heebner	3,501
Toronto	3,522
Lansing	3,542
Base K.C.	3,786
Mar. Lime	3,865
Conglomerate	3,929
Reagan	3,954

I hereby certify that this is a true and correct log of the above described well as shown by the drilling reports.

H-30, INC.

By *C. P. [Signature]*

STATE OF KANSAS)
) SS
COUNTY OF SEDGWICK)

Subscribed and sworn to before me, a notary public, in and for said County and State this 11th day of June, 1957.

[Signature]
Notary Public
RECEIVED
STATE DEPARTMENT OF REVENUE

My Commission expires February 13, 1960.

PLUGGING
FILE SEC. 29 T. 15 R. 20W
BOOK PAGE 31 LINE 14

AUG