


STATE OF KANSAS  
STATE CORPORATION COMMISSION

WELL PLUGGING RECORD

Give All Information Completely  
Make Required Affidavit  
Mail or Deliver Report to  
Conservation Division  
State Corporation Comm.  
245 North Water  
Wichita, KS 67202

McPherson County. Sec. 35 Twp. 31S Rge. 3 E/W  
Location as "NE/CNW 1/4 SW 1/4" or footage from lines \_\_\_\_\_  
NW SW SW  
Lease Owner Sunburst Exploration Company  
Lease Name Foth Gas Unit Well No. 1  
Office Address Suite 708 - One Main Place, Wichita, Ks.  
Character of Well (Completed as Oil, Gas or Dry Hole) 67202  
Dry Hole  
Date Well completed \_\_\_\_\_ 8-21 19 80  
Application for plugging filed \_\_\_\_\_ 8-21 19 80  
Application for plugging approved \_\_\_\_\_ 8-21 19 80  
Plugging commenced \_\_\_\_\_ 8-21 19 80  
Plugging completed \_\_\_\_\_ 8-21 19 80  
Reason for abandonment of well or producing formation \_\_\_\_\_

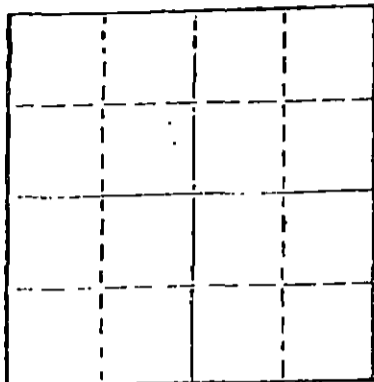

Locate well correctly on above  
Section Plat

If a producing well is abandoned, date of last production \_\_\_\_\_  
19 \_\_\_\_\_

Was permission obtained from the Conservation Division or  
its agents before plugging was commenced? Yes

Name of Conservation Agent who supervised plugging of this well Gilbert Toman  
Producing formation \_\_\_\_\_ Depth to top \_\_\_\_\_ Bottom \_\_\_\_\_ Total Depth of Well 3275'  
Show depth and thickness of all water, oil and gas formations.

OIL, GAS OR WATER RECORDS

CASING RECORD

FORMATION	CONTENT	FROM	TO	SIZE	PUT IN	PULLED OUT
				8 5/8	256'	None

Describe in detail the manner in which the well was plugged, indicating where the mud fluid  
was placed and the method or methods used in introducing it into the hold. If cement or other  
plugs were used, state the character of same and depth placed, from \_\_\_\_\_ feet to  
\_\_\_\_\_ feet for each plug set,

Mud to 270', hulls, plug, 30 sx cement  
Mud to 40', hulls, plug, 12 sx cement  
3 sx cement in rathole

9-10-80


(If additional description is necessary, use BACK of this sheet)

Name of Plugging Contractor White & Ellis Drilling, Inc.  
401 E. Douglas - Suite 500, Wichita, Kansas 67202

STATE OF KANSAS COUNTY OF SEDGWICK, ss.  
Ernest Sifford (employee of owner) or (owner or operator)  
of the above-described well, being first duly sworn on oath, says: That I have knowledge of  
the facts, statements, and matters herein contained and the log of the above-described well  
as filed and that the same are true and correct. So help me God.

(Signature) Ernest Sifford  
401 E. Douglas - Suite 500, Wichita, Ks.  
(Address) 67202

SUBSCRIBED AND SWORN TO before me this 26th day of August, 1980

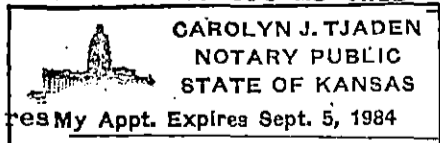

Carolyn J. Tjaden  
Carolyn J. Tjaden - Notary Public.

My commission expires \_\_\_\_\_

DRILLERS LOG

OPERATOR: SUNBURST EXPLORATION COMPANY, Suite 708 - One Main Place, Wichita,  
 CONTRACTOR: White & Ellis Drilling, Inc., Box 448, El Dorado, Kansas 67042 Kansas 67202

Lease Name Foth Gas Unit Well No. 1

Sec. 35 T. 21S R. 3W Spot NW SW SW

County McPherson State Kansas Elevation \_\_\_\_\_

Casing Record:

Surface: 8 5/8 @ 256' with 200 sx Sxs. 3% CC

Production: \_\_\_\_\_ @ \_\_\_\_\_ with \_\_\_\_\_ Sxs.

Type Well: D & A Total Depth 3275'

Drilling Commenced: 8-13-80 Drilling Completed 8-21-80

Formation	From	To	Tops
Cellar	0	8	Mississippi - 3136'
Shale, Sand	8	266	
Shale, Lime	266	2000	
Lime	2000	2190	
Shale, Sand	2190	2379	
Shale	2379	2437	
Lime	2437	2448	
Shale, Lime	2448	2710	
Lime	2710	2829	
Shale, Lime	2829	3136	
Lime	3136	3275	

RECEIVED  
 STATE COMMISSIONER OF GEAS  
 SEP 10 1980  
 OIL & GAS DIVISION  
 WICHITA, KANSAS

COMPLETION RECORD

Liner Record: Size \_\_\_\_\_ From \_\_\_\_\_ To \_\_\_\_\_

Cementing Record: \_\_\_\_\_ Sacks \_\_\_\_\_

Perforating Record:

Formation	Perforated Interval	Number Shots

Initial Production: \_\_\_\_\_

Electric Log \_\_\_\_\_ Type and Depths Covered \_\_\_\_\_