


STATE OF KANSAS
STATE CORPORATION COMMISSION

WELL PLUGGING RECORD

Give All Information Completely
Make Required Affidavit
Mail or Deliver Report to:
Conservation Division
State Corporation Commission
800 Biting Building
Wichita, Kansas

NORTH

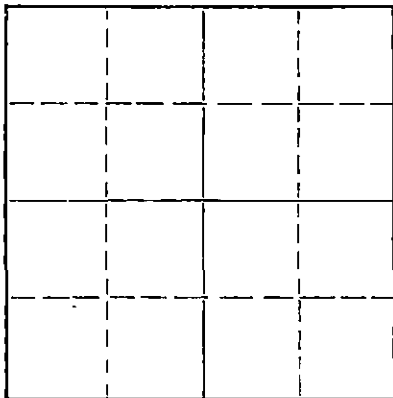

Locate well correctly on above
Section Plat

McPherson County. Sec. 17 Twp. 21S Rge. 1 (W)
Location as "NE/CNW%SW%" or footage from lines Cen. E/2 E/2 SW/4
Lease Owner J. P. Gaty
Lease Name Chavez Well No. 4
Office Address 11 Cypress Drive, Forrest Hills, Wichita, Kansas
Character of Well (completed as Oil, Gas or Dry Hole) Dry Hole
Date well completed March 11 19 57
Application for plugging filed 19
Application for plugging approved 19
Plugging commenced March 11, 19 57
Plugging completed March 11, 19 57
Reason for abandonment of well or producing formation Dry Hole
If a producing well is abandoned, date of last production 19
Was permission obtained from the Conservation Division or its agents before plugging was commenced? Yes

Name of Conservation Agent who supervised plugging of this well Ruel Durkee
Producing formation Depth to top Bottom Total Depth of Well 3340 Feet
Show depth and thickness of all water, oil and gas formations.

OIL, GAS OR WATER RECORDS

CASING RECORD

FORMATION	CONTENT	FROM	TO	SIZE	PUT IN	PULLED OUT

Describe in detail the manner in which the well was plugged, indicating where the mud fluid was placed and the method or methods used in introducing it into the hole. If cement or other plugs were used, state the character of same and depth placed, from feet to feet for each plug set.

Gun up Pits. Circulate till heavy mud comes around before laying down drill pipe. Build solid bridge at 188'. Pour 15 sacks of mixed cement thru 6 joints drill pipe. Fill hole up to within 18' of base of cellar with rotary mud. Set 3' solid bridge and cap with 5 sacks cement.

(If additional description is necessary, use BACK of this sheet)
Name of Plugging Contractor Morrison Drilling Company, Inc.
Address Drawer 712, El Dorado, Kansas

STATE OF KANSAS, COUNTY OF Sedgewick, ss.
D. M. Peet (employee of owner) or (owner or operator) of the above-described well, being first duly sworn on oath, says: That I have knowledge of the facts, statements, and matters herein contained and the log of the above-described well as filed and that the same are true and correct. So help me God.
(Signature) D. M. Peet

SUBSCRIBED AND SWORN to before me this 18th day of March, 1957
My commission expires December 12, 1957
J. Arnold Howard Notary Public.

PLUGGING
FILE SEC. 17 T. 21 R. 1W
BOOK PAGE 148 LINE 42

RECEIVED
STATE CORPORATION COMMISSION

MAR 19 1957
CONSERVATION DIVISION
Wichita, Kansas

OWNER:

Mr. J. P. Gaty
11 Cypress Drive
Perrest Hills
Wichita, Kansas

LOCATION: Sec 1/2 E/2 S1/4
Section 17-21S-1.
McPherson County, Kans.

CONTRACTOR:

Morrison Drilling Company, Inc.
Traver 712
Colorado, Kansas

PRODUCTION: _____

Name:

Chavez - Well 4

Date Commenced:

March 2, 1957

Date Completed:

March 11, 1957

Total Depth:

3540 - Rotary

From	To	Formation
145	188	Plug and Cement
188	400	Shale and Shells
400	710	Lime and Shale
710	830	Shale and Lime Streaks
830	970	Shale and Lime
970	1070	Lime
1070	1150	Lime and Shale
1150	1460	Shale and Lime Streaks
1460	1530	Shale and Lime
1530	1580	Shale
1580	1970	Shale and Lime Streaks
1970	2450	Lime and Shale
2450	2645	Lime
2645	2916	Shale and Lime
2916	2930	Lime
2930	2945	Chert
2945	2970	Lime
2970	3020	Chert
3020	3200	Lime
3200	3253	Lime and Shale Streaks
3253	3316	Limed Shale
3316	3320	Sand
3320	3340	Lime
3340		Total Depth

I hereby certify that the foregoing is a true and correct copy of the well log for the Chavez #4 Well drilled for J. P. Gaty and completed March 11, 1957.

MORRISON DRILLING COMPANY, INC.

[Signature]

G. P. Wilson - Secretary-Treasurer

STATE OF KANSAS)

) ss:

COUNTY OF BUTLER)

SUBSCRIBED AND SWORN To Before the Undersigned, a Notary Public in and for County and State aforesaid this 13th day of March, 1957.

PLUGGING
FILE SEC. 17 T. 21 R. 1W
BOOK PAGE 148 LINE 42

[Signature]
Notary Public

My Commission Expires: April 27, 1957