


STATE OF KANSAS
STATE CORPORATION COMMISSION

WELL PLUGGING RECORD

Give All Information Completely
Make Required Affidavit
Mail or Deliver Report to
Conservation Division
State Corporation Comm.
245 North Water
Wichita, KS 67202

McPherson County, Sec. 17 Twp. 21 Rge. I W E/W
Location as "NE/CNW $\frac{1}{4}$ SW $\frac{1}{4}$ " or footage from lines
NE NE SW

Lease Owner E. K. Loewen
Lease Name Chavee Well No. I
Office Address 208 So. Main Canton, Kansas 67428
Character of Well (Completed as Oil, Gas or Dry Hole) oil

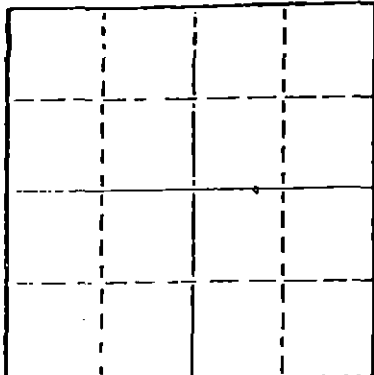

Locate well correctly on above
Section Plot

Date Well completed 10-27 1975
Application for plugging filed 5-25 1978
Application for plugging approved 5-26 1978
Plugging commenced 7-3 1978
Plugging completed 7-5 1978
Reason for abandonment of well or producing formation _____

If a producing well is abandoned, date of last production
19 _____

Was permission obtained from the Conservation Division or
its agents before plugging was commenced? yes

Name of Conservation Agent who supervised plugging of this well Gilbert Toman
Producing formation _____ Depth to top _____ Bottom _____ Total Depth of Well 3365'
Show depth and thickness of all water, oil and gas formations.

OIL, GAS OR WATER RECORDS

CASING RECORD

FORMATION	CONTENT	FROM	TO	SIZE	PUT IN	PULLED OUT
				5 $\frac{1}{2}$ "		2415'

Describe in detail the manner in which the well was plugged, indicating where the mud fluid was placed and the method or methods used in introducing it into the hold. If cement or other plugs were used, state the character of same and depth placed, from _____ feet to _____ feet for each plug set.

Plugged off bottom of hole with sand.
Sand from 3365' to 2900'. Dumped 5 sx
of cement. Mudded hole to 160'. Made
10' of rock bridge. Dumped 35 sx cement.
Mudded hole to 40'. Made 10' of rock
bridge. Dumped 10 sx of cement, filling
to the bottom of the celler.

RECEIVED
STATE CORPORATION COMMISSION

JUL 10 1978

CONSERVATION DIVISION
Wichita, Kansas

(If additional description is necessary, use BACK of this sheet)

Name of Plugging Contractor Art Lamb Casing Pulling Inc.
2809 King St. Hutchinson, Kansas 67501


STATE OF Kansas COUNTY OF Reno, ss.
Art Lamb (employee of owner) or (owner or operator)
of the above-described well, being first duly sworn on oath, says: That I have knowledge of the facts, statements, and matters herein contained and the log of the above-described well as filed and that the same are true and correct. So help me God.

(Signature) Art Lamb
2809 King St. Hutchinson, Kansas
(Address)

SUBSCRIBED AND SWORN TO before me this 7th day of July, 1978

My commission expires April 18, 1982

Judy Lamb
Notary Public.

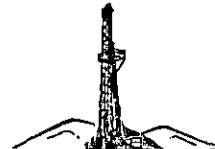

Blackstone Drilling, Inc.

Box 1184 523 West Kansas • Phone (316) 241-1250
McPHERSON, KANSAS 67460

October 27, 1977

COMPANY: E. K. LOEWEN
 CONTRACTOR: BLACKSTONE DRILLING, INC.
 FARM: CHAVEZ #1
 LOCATION: NE NE SW Section 17-21S-1W,
 McPherson County, Kansas
 COMMENCED: October 21, 1977
 COMPLETED: October 27, 1977
 ELEVATION:

0	to	85	Shale & Sand
85	to	131	Blue Shale
131	to	625	Shale & Lime
625	to	1055	Lime & Shale
1055	to	1780	Shale & Lime
1780	to	2155	Lime
2155	to	2415	Shale & Lime
2415	to	2820	Lime
2820	to	2930	Shale & Lime
2930	to	2944	Lime
2944	to	3250	Mississippi
3250	to	3344	Kinderhook
3344	to	3355	Hunton
3355	to	3365	Maquoketa
		3365	T. D.

Cut 12 1/2" hole to 131' and run 133.88' of 8 5/8" surface, cemented with 100 sacks at 131'. Plug down at 11:00 A. M., October 21, 1977. Cut 7 7/8" hole to 3365'. Run 3082' of 5 1/2" casing, cemented with 75 sacks of cement at 3082'. Plug down at 3:00 A. M., October 27, 1977. T. D.

TOPS: MISSISSIPPI - 2944' KINDERHOOK - 3250' HUNTON - 3344'
 MAQUOKETA - 3355'

Measurements taken from K. B.

CERTIFICATE

I, P. E. Plouffe, President of Blackstone Drilling, Inc. do hereby certify that the above and foregoing is true and correct copy of log on your Chavez #1, located on the NE/4 NE/4 SW/4, Section 17-21S-1W, McPherson County, Kansas as reflected by the files of Blackstone Drilling, Inc.


 P. E. Plouffe, President

Subscribed and sworn to before me a Notary Public in and for McPherson County, Kansas this 27th day of October, 1977.


 Johnnie L. Schmidt - Notary Public

