


STATE OF KANSAS
STATE CORPORATION COMMISSION

WELL PLUGGING RECORD

Give All Information Completely
Make Required Affidavit
Mail or Deliver Report to:
Conservation Division
State Corporation Commission
211 No. Broadway
Wichita, Kansas

McPherson County. Sec. 17 Twp. 21S Rge. 1 (E) 1 (W)
Location as "NE/CNW/SW" or footage from lines. NE NW NE
Lease Owner Stickle Drilling Company
Lease Name Goering "B" Well No. 1
Office Address 1027 Union Center, Wichita 2, Kansas
Character of Well (completed as Oil, Gas or Dry Hole) Dry Hole
Date well completed. 18 July 19 59
Application for plugging filed. 17 July 19 59
Application for plugging approved. 17 July 19 59
Plugging commenced. 18 July 19 59
Plugging completed. 18 July 19 59
Reason for abandonment of well or producing formation Dry Hole

NORTH

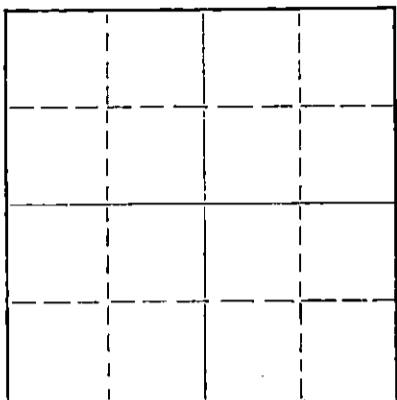

Locate well correctly on above
Section Plat

If a producing well is abandoned, date of last production. 19
Was permission obtained from the Conservation Division or its agents before plugging was com-
menced? Yes

Name of Conservation Agent who supervised plugging of this well Gilbert J. Toman
Producing formation - Depth to top - Bottom - Total Depth of Well 3430 Feet
Show depth and thickness of all water, oil and gas formations.

OIL, GAS OR WATER RECORDS

CASING RECORD

FORMATION	CONTENT	FROM	TO	SIZE	PUT IN	PULLED OUT

Describe in detail the manner in which the well was plugged, indicating where the mud fluid was placed and the method or methods used in introducing it into the hole. If cement or other plugs were used, state the character of same and depth placed, from _____ feet to _____ feet for each plug set.

Heavy rotary mud was placed from the total depth to 160 feet with the drill pipe.

A plug of 1/4 sack hulls and 20 sacks of cement was placed at 160 feet through the drill pipe.

Heavy rotary mud was then placed to 40 feet.

1/4 sack of Hulls, a wood plug and 10 sacks of cement were placed at 40 feet.

2 sacks of cement were placed in the rat hole.

AUG 5 1959
CONSERVATION DIVISION
Wichita, Kansas

(If additional description is necessary, use BACK of this sheet)
Name of Plugging Contractor Stickle Drilling Company
Address 1027 Union Center, Wichita 2, Kansas

STATE OF KANSAS, COUNTY OF SEDGWICK, ss.
Clifford M. Smith (employee of owner) or (owner or operator) of the above-described well, being first duly sworn on oath, says: That I have knowledge of the facts, statements, and matters herein contained and the log of the above-described well as filed and that the same are true and correct. So help me God.

(Signature) Clifford M. Smith
1027 Union Center, Wichita 2, Kansas
(Address)

SUBSCRIBED AND SWORN to before me this 4th day of August 1959

My commission expires 17 February 1962 Charley V. Shank Notary Public.

PLUGGING
FILE SEC. 17 T. 21 R. 1W
BOOK PAGE 58 LINE 4

Stickle Drilling Company, Etal
Wichita, Kansas

Tulsa, Oklahoma
July 20, 1959

CONTRACTOR: Stickle Drilling Company
Drilling Commenced: July 9, 1959
Drilling Completed: July 18, 1959

Goering "B" #1 NE NW NE
Sec. 17-21S-1W, McPherson
County, Kansas.

DRILLERS LOG

Surface	0
Shale & Sand	160
Shale & Shells	320
Shale & Lime	440
Lime & Shale	700
Shale & Lime	1170
Shale & Shells	1615
Shale & Lime	2340
Lime	2440
Lime & Shale	2730
Shale	2800
Shale & Lime	2940
Chert	3006
Lime	3010
Chert	3145
Lime & Chert	3195
Shale & Lime	3325
Shale & Sand	3365
Lime & Shale	3430 TD

RECEIVED
STATE CORPORATION COMMISSION

AUG 5 1959

CONSERVATION DIVISION
Wichita, Kansas

I, Fred E. Stickle hereby certify the above to be a true and complete
Drillers Log of Stickle Drilling Company, Etal #1 Goering "B" located
in the NE NW NE Section 17-21S-1E, McPherson County, Kansas.

Fred E. Stickle
Fred E. Stickle

Edith D. Hoff
Notary Public

My Commission Expires September 12 1962
Commission Expires

PLUGGING
FILE SEC. 17 T. 21 R. 14
BOOK PAGE 58 LINE 4